

LOWNDES

WATER WELL DRILLERS LOG

K 2004

Date: 2-1-1962, Driller: E. B. Newwood County, Noxubee

15992 16051, 213

(Name)

(1) Owner of Land: E. E. Wicks
(Name)

Antevic, Miss.
(Address) 30 18. 17E

(2) Location: 1/4, 1/4, Sec. 19 T18R17,

6 miles east of Antevic
(distance) (direction) (Nearest Town)

(3) Topography: Hilly
(Hilly) (Flat) (Level)

(4) Purpose of Well: Farm use
(Domestic Irrigation
Municipal, Industrial, Other)

Description & Color of Materials
Sand, Clay, Red Clay, Shell, etc.

Thick-
ness
Feet

Depth-
Feet

Clay	0	12
Blue Rock	12	317
Sand	317	378
Shell	378	434
Sand	434	458
Shell	458	497
Sand	497	509
Shell	509	526
Sand	526	535
Shell	535	594
Sand	594	618
Shell	618	632
Sand	632	655
Shell	655	670
Sand	670	687

Information upon completion of well:

(1) Diameter 4 inches.

(2) Total Depth 687 feet.

(3) Water Level 76 feet below top of ground.

(4) Cased to Blue Rod, Size 20'-4'

perforated pipe
(5) Screen: Size 2", Length 400'


(6) Were any formations sealed against pollution?

yes, no.

If YES depth of formation

Why

Drillers Remarks:

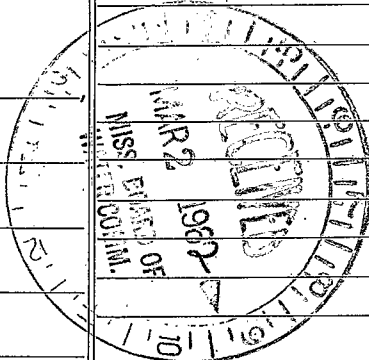

(Use Back Side)

Well No.

6	5	4	3	2	1
7	8	9	10	11	12
13	14	15	16	17	18
19	20	21	22	23	24
25	26	27	28	29	30
31	32	33	34	35	36