

Edward Anderson

Landowner
R 2005
6-23-75

MISSISSIPPI
BOARD OF WATER COMMISSIONERS
416 North State Street
Jackson, Mississippi 39201

WATER WELL DRILLERS LOG

4/23 1975 Norman Ebel Founder
date well completed firm name county well located

LANDOWNER:
County Ship
Columbus Miss
(mailing address)

description of formations encountered	from	to
top soil	0	10
clay	10	280
sand	280	400

WELL LOCATION:
sec. 10 T. 13 N R. 17 E
S W
5 miles S.W. of Columbus
(distance) (direction) (nearest town)

WELL PURPOSE:
(home, irrigation, municipal, industrial)

- WELL COMPLETION DATA:
- (1) diameter (inches) 5
 - (2) total depth (feet) 400
 - (3) static water level (feet) 70 below top of ground.
 - (4) casing 21' steel (material) (depth)
 - (size) If telescope see back.
 - (5) screen (length) (depth to top)
 - (size) (material)
 - (6) pump 1/2 (HP) 10 GPM (yield gpm)
 - (type power)
 - (7) electric log (yes or no)
 - (organization running log)
 - (8) how well bottom plugged


DRILLERS REMARKS:

RECEIVED
NOV 12 1975

MISS. BD. OF WATER COMMISSIONERS

If well telescopes please sketch and show depths.

GROUND LEVEL

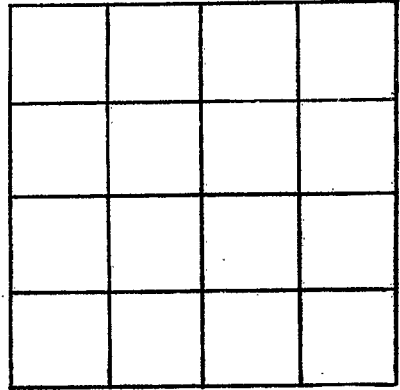

SECTION _____

Please indicate well location X.

ADDITIONAL INFORMATION

If more than one screen, show locations of each on sketch.