

Lowndes
K 2006
6-25-75

MISSISSIPPI
 BOARD OF WATER COMMISSIONERS
 416 North State Street
 Jackson, Mississippi 39201

WATER WELL DRILLERS LOG

6/25 1975 Norman Edick Lowndes
 date well completed firm name county well located

LANDOWNER: Tom Lamar
R7D
Clarks, Miss
 (mailing address)

description of formations encountered	from to	
<u>top soil</u>	<u>0</u>	<u>19</u>
<u>clay</u>	<u>19</u>	<u>260</u>
<u>Sand</u>	<u>260</u>	<u>320</u>

WELL LOCATION:
 sec. 16 N 13L
S R-17 E
6 miles SW of Clarks
 (distance) (direction) (nearest town)

WELL PURPOSE:
 (home, irrigation, municipal, industrial)

- WELL COMPLETION DATA:
- diameter (inches) 5"
 - total depth (feet) 380
 - static water level (feet) 100 below top of ground.
 - casing 21' 5" Steel, 4" 4"
 (material) (depth)
 (size) if telescope see back.
 - screen _____
 (length) (depth to top)
 (size) (material)
 - pump 1/2 10 GPM
 (HP) (yield gpm)
Electric
 (type power)
 - electric log (yes or no) _____
 (organization running log) _____
 - how well bottom plugged _____


DRILLERS REMARKS: _____

RECEIVED
 NOV 12 1975

MISS. BD. OF WATER COMMISSIONERS

If well telescopes please sketch and show depths.

GROUND LEVEL

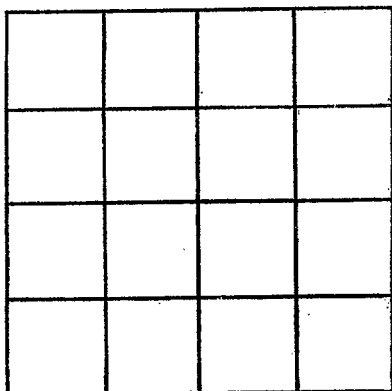

SECTION _____

Please indicate well location X.

ADDITIONAL INFORMATION

If more than one screen,
show locations of each on sketch.