

*Lauderdale*  
*K 2007*  
*7-1-75*

MISSISSIPPI  
 BOARD OF WATER COMMISSIONERS  
 416 North State Street  
 Jackson, Mississippi 39201

WATER WELL DRILLERS LOG

*7/1 75* 19*75* *Norman Elder* *Lauderdale*  
 date well completed firm name county well located

LANDOWNER: *Best Heart*  
*R2D*  
*Columbus, Miss*  
 (mailing address)

description of formations encountered	from to	
<i>Clay</i>	<i>0</i>	<i>16</i>
<i>Shale</i>	<i>16</i>	<i>260</i>
<i>Sand</i>	<i>260</i>	<i>380</i>

WELL LOCATION:  
 sec. *15* T. *18* N. R. *17* E *13L*  
*S* *W*  
*6* miles *SW* of *Columbus*  
 (distance) (direction) (nearest town)

WELL PURPOSE: *Home*  
 (home, irrigation, municipal, industrial)


- WELL COMPLETION DATA:
- (1) diameter (inches) *5"*
  - (2) total depth (feet) *380*
  - (3) static water level (feet) *80* below top of ground.
  - (4) casing *5" Steel*  
 (material) (depth)  
 (size) if telescope see back.
  - (5) screen \_\_\_\_\_  
 (length) (depth to top)  
 (size) (material)
  - (6) pump *L* *5*  
 (HP) (yield gpm)  
*Electric*  
 (type power)
  - (7) electric log (yes or no)
  - (organization running log)
  - (8) how well bottom plugged \_\_\_\_\_

DRILLERS REMARKS:

**RECEIVED**  
**NOV 12 1975**  
 MISS. BD. OF WATER COMMISSIONERS

If well telescopes please sketch and show depths.

GROUND LEVEL

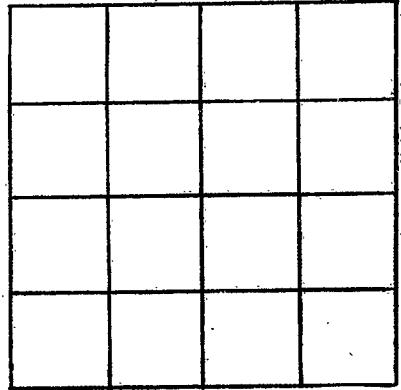

SECTION \_\_\_\_\_

Please indicate well location X.

ADDITIONAL INFORMATION

If more than one screen, show locations of each on sketch.