

LOWNDES
K 2009
6-3-76

MISSISSIPPI
 BOARD OF WATER COMMISSIONERS
 416 North State Street
 Jackson, Mississippi 39201

WATER WELL DRILLERS LOG

6-3 1976 W J REEVES & SON LOWNDES
 date well completed firm name county well located

LANDOWNER: JOE HARRIS JR.
RT 1
COLUMBUS
 (mailing address)
 WELL LOCATION:
 sec 22 T 18 N ? R 17 E
6 miles S of Columbus
 (distance) (direction) (nearest town)

description of formations encountered	depth	
	from	to
BLUE CLAY	0	155
BLUE CLAY-SANDY	155	210
BLUE SAND + CLAY	210	275
BLUE CLAY	275	305
" SAND	305	330
" CLAY	330	348
BLUE SAND + CLAY	348	380

WELL PURPOSE: Home
 (home, irrigation, municipal, industrial)

WELL COMPLETION DATA:
 (1) diameter (inches) 4
 (2) total depth (feet) 380
 (3) static water level (feet) 32 below above top of ground.
 (4) casing STEEL, 42
 (material) (depth)
 (size) if telescope see back.
 (5) screen _____
 (length) (depth to top)
 (size) (material)
 (6) pump _____
 (HP) (yield gpm)
 (type power)
 (7) electric log NO
 (yes or no)
 (organization running log)
 (8) how well bottom plugged OPEN


DRILLERS REMARKS:

RECEIVED
 APR 12 1977

MISS. Bd. OF WATER COMMISSIONERS

If well telescopes please sketch and show depths.

GROUND LEVEL

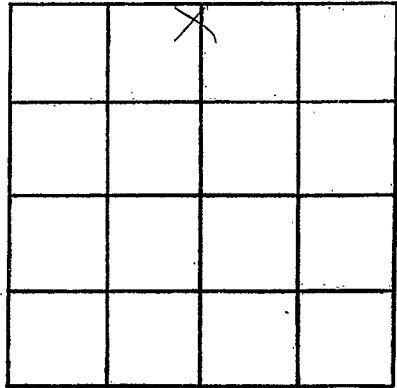

SECTION 22

Please indicate well location X.

ADDITIONAL INFORMATION

If more than one screen, show locations of each on sketch.