

Lowndes  
 K 2010  
 10/1/76  
 7

MISSISSIPPI  
 BOARD OF WATER COMMISSIONERS  
 416 North State Street  
 Jackson, Mississippi 39201

WATER WELL DRILLERS LOG

0794L 1976 Allsup Drilling Inc. Lowndes  
 date well completed firm name county well located

LANDOWNER: Mr. Tommy Flowers  
 & Mrs. Peach Ella Flowers  
 Route 1 Box 247  
 Crawford MS. (mailing address) 3

WELL LOCATION:  
 sec 30 T 18 N R 17 E  
 5 miles E of Artesia  
 (distance) (direction) (nearest town)

WELL PURPOSE: home  
 (home, irrigation, municipal, industrial)

- WELL COMPLETION DATA:
- (1) diameter (inches) 4" x 2"
  - (2) total depth (feet) 600'
  - (3) static water level (feet) ~~327~~ 225 below top of ground.
  - (4) casing plastic, 27' (material) (depth)  
 4" x 2" if telescope see back. (size)
  - (5) screen 80' 520' (length) (depth to top)  
 2" plastic (size) (material)
  - (6) pump 1/2 10 (HP) (yield gpm)  
 Electric (type power)
  - (7) electric log NO (yes or no)

(organization running log)  
 (8) how well bottom plugged CAP

DRILLERS REMARKS:

description of formations encountered	from to	
	feet	feet
TOP SOIL	0	4
CLAY	4	17
CHALK	17	24
BLUEROCK	24	88
WHITEROCK	88	501
MUCK	501	509
SAND	509	600

RECEIVED


MAR - 9 1977

MISS. BD. OF WATER COMMISSIONERS

If well telescopes please sketch and show depths.

GROUND LEVEL

27'4"  
Casing

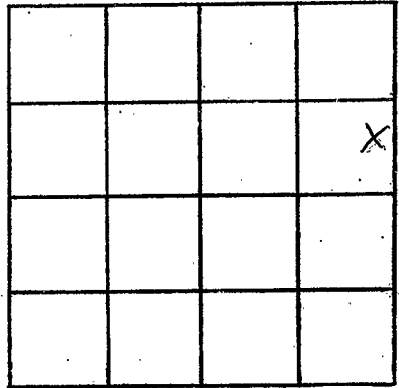

SECTION 30

Please indicate well location X.

ADDITIONAL INFORMATION

120'2"  
Casing

80' screen

If more than one screen,  
show locations of each on sketch.