

Lowndes
 K 2012
 161, /76

MISSISSIPPI
 BOARD OF WATER COMMISSIONERS
 416 North State Street
 Jackson, Mississippi 39201

WATER WELL DRILLERS LOG

7 FALL 1976 date well completed
 26 Ahk Sup Drilling Inc. firm name
 Lowndes county well located

LANDOWNER: Mr. Coolidge
 Phillids
 Rt 1 Box 333 Columbus MS.
 (mailing address)

WELL LOCATION:
 sec. 30 T 18 N R 17 E
 4 3/4 miles E of Artesia
 (distance) (direction) (nearest town)

WELL PURPOSE: home
 (home, irrigation, municipal, industrial)

- WELL COMPLETION DATA:
- (1) diameter (inches) 4" x 2"
 - (2) total depth (feet) 600'
 - (3) static water level (feet) 80' below top of ground
 - (4) casing plastic 27' (material) (depth)
 4" x 2" if telescope see back. (size)
 - (5) screen 80' 520' (length) (depth to top)
 plastic (material) (size)
 - (6) pump 1/2 10 (HP) (yield gpm)
 Electric (type power)
 - (7) electric log NO (yes or no)
 (organization running log)
 - (8) how well bottom plugged CAP

description of formations encountered	from	to
TOP SOIL	0	4
CLAY	4	18
CHALK	18	28
BLUE ROCK	28	25
WHITE ROCK	25	500
MUCK	500	502
SAND	502	510
MUCK	510	512
SAND	512	600

RECEIVED
 MAR - 9 1977
 MISS. BD. OF WATER COMMISSIONERS

DRILLERS REMARKS:


If well telescopes please sketch and show depths.

GROUND LEVEL

27'
4" casing

200' 2"
casing

10'
screen

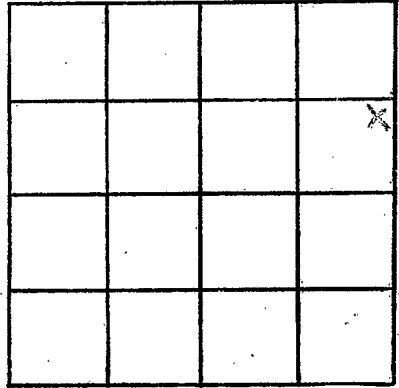

SECTION 30

Please indicate well location X.

ADDITIONAL INFORMATION

If more than one screen, show locations of each on sketch.