

LOWNDES  
K 7015  
3-2-78

MISSISSIPPI  
BOARD OF WATER COMMISSIONERS  
416 North State Street  
Jackson, Mississippi 39201

WATER WELL DRILLERS LOG

March 2 1978 ALLsup Drilling INC. Lowndes  
date well completed firm name county well located

LANDOWNER: Dr. Wayne Bailey  
302 Shoney Drive  
Columbus, MS. 39701  
(mailing address)

| Description of formations encountered | from | to  |
|---------------------------------------|------|-----|
| Top Soil                              | 0    | 12  |
| Lime Rock                             | 12   | 140 |
| 1st SAND                              | 140  | 190 |
| Muck                                  | 190  | 260 |
| 2nd SAND                              | 260  | 300 |

WELL LOCATION:  
sec 15 T 18 N R 17 E  
8 miles SW of Columbus  
(distance) (direction) (nearest town)

WELL PURPOSE: ~~Home~~ Home  
(home, irrigation, municipal, industrial)

- WELL COMPLETION DATA:
- (1) diameter (inches) 4" X 2"
  - (2) total depth (feet) 300'
  - (3) static water level (feet) 30' below top of ground.
  - (4) casing 4" DIASTIC, 100' (material) (depth)
  - 2" If telescope see back. (size)
  - (5) screen 80' 220' (length) (depth to top)
  - 2" PLASTIC (size) (material)
  - (6) pump 1/2 9 (HP) (yield gpm)
  - Electric (type power)
  - (7) electric log NO (yes or no)
  - (organization running log)
  - (8) how well bottom plugged CAP

RECEIVED  
MAY 12 1978

MISS. Bd. OF WATER COMMISSIONERS

DRILLERS REMARKS:


If well telescopes please sketch and show depths.

GROUND LEVEL

100'  
4" casing

130'  
2" casing

80' Com.  
screen

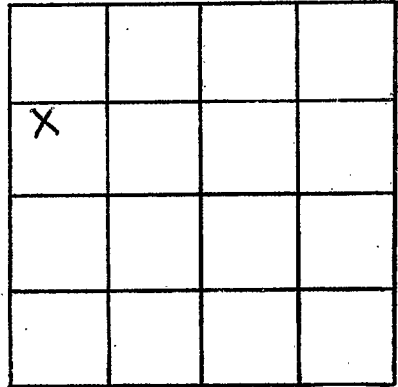

SECTION 15

Please indicate well location X.

ADDITIONAL INFORMATION

If more than one screen,  
show locations of each on sketch.