

LOWNDESZ
K 206
6-15-78

MISSISSIPPI
BOARD OF WATER COMMISSIONERS
416 North State Street
Jackson, Mississippi 39201

WATER WELL DRILLERS LOG

June 15 1978 Allsup Drilling, Inc. LOWNDESZ
date well completed firm name county well located

LANDOWNER: Mr. & Mrs.
Robert RAY Morris
Trt. 3 Box 170 A
Columbus, MS. 39701
(mailing address)

description of formations encountered	from	to
Top Soil clay	0	10
Lime Rock	10	360
1 SAND	360	410
MUCK	410	430
2ND SAND	430	480'

WELL LOCATION:
sec 14 T 9 N R 17 E
S
8 miles S of Columbus
(distance) (direction) (nearest town)

WELL PURPOSE: home
(home, irrigation, municipal, industrial)

- WELL COMPLETION DATA:
- diameter (inches) 4" x 2"
 - total depth (feet) 480'
 - static water level (feet) 60' below top of ground.
 - casing 4" plastic 30' (material) (depth)
4" x 2" (size) if telescope see back.
 - screen 80' 400' (length) (depth to top)
4" x 2" plastic (size) (material)
 - pump 1/2 9 (HP) (yield gpm)
Electric (type power)
 - electric log NO (yes or no)
(organization running log)
 - how well bottom plugged. CAP

RECEIVED
JUN 29 1978


MISS. BD. OF WATER COMMISSIONERS

DRILLERS REMARKS:

If well telescopes please sketch and show depths.

GROUND LEVEL

30'
4" casing

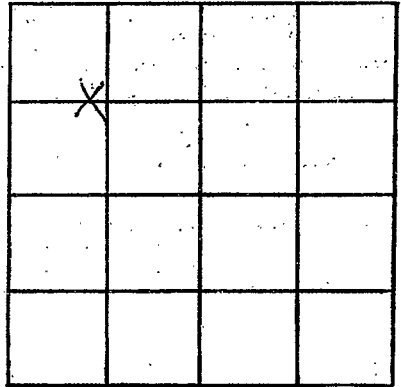

SECTION 14

Please indicate well location X.

ADDITIONAL INFORMATION

400'
2" casing
80' C. Screen

more than one screen,
locations of each on sketch.