

LOWNDES
K 2018
7/02/79

**MISSISSIPPI
BOARD OF WATER COMMISSIONERS**
416 North State Street
Jackson, Mississippi 39201

WATER WELL DRILLERS LOG

July 2 1979 Mid South Drilling Loundes
 date well completed firm name county well located

LANDOWNER: <u>Kick Miller</u>	description of formations encountered	from	to
<u>Rt. 3 Box 266 F</u>			
<u>Columbus MS 39101</u> (mailing address)	<u>clay</u>	<u>0</u>	<u>135</u>
WELL LOCATION: sec <u>4</u> T <u>18</u> N R <u>17</u> E <u>4</u> miles <u>W</u> of <u>Columbus</u> (distance) (direction) (nearest town)	<u>clay & sand</u>	<u>135</u>	<u>180</u>
WELL PURPOSE: <u>home</u> (home, irrigation, municipal, industrial)	<u>sand</u>	<u>180</u>	<u>205</u>
WELL COMPLETION DATA:	<u>clay</u>	<u>205</u>	<u>247</u>
(1) diameter (inches) <u>4</u>	<u>sand</u>	<u>247</u>	<u>255</u>
(2) total depth (feet) <u>375</u>	<u>clay & sand</u>	<u>255</u>	<u>360</u>
(3) static water level (feet) <u>50</u> below above top of ground.	<u>clay</u>	<u>360</u>	<u>375</u>
(4) casing <u>PVC, 140</u> (material) (depth) <u>4</u> if telescope see back. (size)			
(5) screen <u>None</u> (length) (depth to top) (size) (material)			
(6) pump <u>1/2</u> <u>10</u> (HP) (yield gpm) <u>electric</u> (type power)			
(7) electric log <u>no</u> (yes or no) <u>no</u> (organization running log)			
(8) how well bottom plugged <u>Open</u>			
DRILLERS REMARKS:			


Miss. Board of Water Comm.

AUG 23 1979

RECEIVED

If well telescopes please sketch and show depths.

GROUND LEVEL

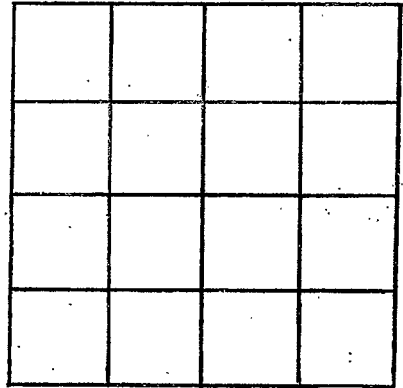

SECTION _____

Please indicate well location X.

ADDITIONAL INFORMATION

If more than one screen,
show locations of each on sketch.