

LOWNDES
K 7070
10-11-79

MISSISSIPPI
 BOARD OF WATER COMMISSIONERS
 416 North State Street
 Jackson, Mississippi 39201

WATER WELL DRILLERS LOG

Oct 11 date well completed 1979 Mid South Drilling firm name Loundes county well located

LANDOWNER: <u>Charles Norris</u>	description of formations encountered	from	to
<u>Columbus MS</u> (mailing address)	<u>clay</u>	<u>0</u>	<u>105</u>
WELL LOCATION: sec <u>2</u> T <u>18</u> N R <u>17</u> E	<u>clay & sand</u>	<u>105</u>	<u>120</u>
<u>5</u> miles <u>SW</u> of <u>Columbus</u> (distance) (direction) (nearest town)	<u>clay</u>	<u>120</u>	<u>150</u>
WELL PURPOSE: <u>home</u> (home, irrigation, municipal, industrial)	<u>clay & sand</u>	<u>150</u>	<u>300</u>
WELL COMPLETION DATA:	<u>Rocket 128'</u>		
(1) diameter (inches) <u>4</u>			
(2) total depth (feet) <u>300</u>			
(3) static water level (feet) <u>40</u> below top of ground.			
(4) casing <u>PVC</u> , <u>100'</u> (material) (depth)			
<u>4"</u> (size) if telescope see back.			
(5) screen <u>N/A</u> (length) (depth to top)			
(6) pump <u>1/2</u> <u>S</u> (HP) (yield gpm)			
<u>electric</u> (type power)			
(7) electric log <u>no</u> (yes or no)			
<u>no</u> (organization running log)			
(8) how well bottom plugged <u>open</u>			
DRILLERS REMARKS:			


DEPT. OF NATURAL RESOURCES
 DIVISION OF LAND & WATER RESOURCES

JAN 7 1980

RECEIVED

If well telescopes please sketch and show depths.

GROUND LEVEL

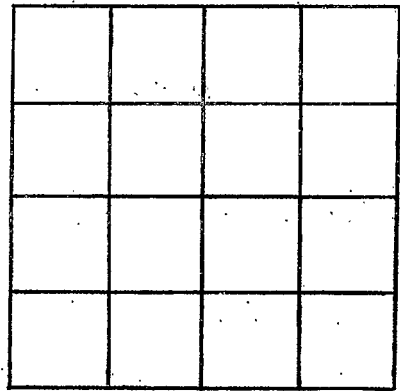

SECTION _____

Please indicate well location X.

ADDITIONAL INFORMATION

If more than one screen, show locations of each on sketch.