

LOWNDES
K 2021
12/10/79

MISSISSIPPI
 BOARD OF WATER COMMISSIONERS
 416 North State Street
 Jackson, Mississippi 39201

WATER WELL DRILLERS LOG

12/10 date well completed 1979 Ahl Sup Drilling INC. firm name Lowndes county well located

LANDOWNER: Mr. Ellis
Jennings - Prairie Chapel
1201 6th Street South
Columbus, Ms. 39701
 (mailing address)

description of formations encountered	from	to
Top Soil	0	8
lime Rock	8	300
1st SAND	300	330
Muck	330	360
2nd SAND	360	625'

WELL LOCATION:
 sec. 16 T. 18 N. R. 17 E
6 miles SW of Columbus
 (distance) (direction) (nearest town)

WELL PURPOSE: CHURCH
 (home, irrigation, municipal, industrial)

- WELL COMPLETION DATA:
- (1) diameter (inches) 4" X 2"
 - (2) total depth (feet) 625'
 - (3) static water level (feet) 84 below above top of ground.
 - (4) casing 4" plastic, 27'
 (material) (depth)
4" X 2" if telescope see back.
 (size)
 - (5) screen 80' 545'
 (length) (depth to top)
4" X 2" plastic
 (size) (material)
 - (6) pump 1/2 10
 (HP) (yield gpm)
Electric
 (type power)
 - (7) electric log NO
 (yes or no)
- (organization running log)
- (8) how well bottom plugged CAP

DRILLERS REMARKS:

DEPT. OF NATURAL RESOURCES
 BUREAU OF LAND & WATER RESOURCES


JAN 28 1980

RECEIVED

If well telescopes please sketch and show depths.

GROUND LEVEL

27'
4" Casing

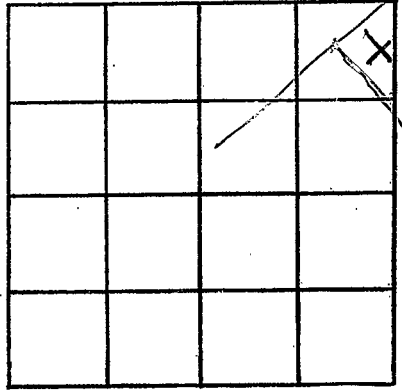

SECTION 16

Please indicate well location X.

ADDITIONAL INFORMATION

140'
2" Casing

80' 2"
Commercial
Screens

If more than one screen,
show locations of each on sketch.