

Laundrey
K
2022

MISSISSIPPI
 BOARD OF WATER COMMISSIONERS
 416 North State Street
 Jackson, Mississippi 39201

WATER WELL DRILLERS LOG

6-15
 date well completed

92 Martin S. R. Laundrey
 firm name

Laundrey
 county well located

LANDOWNER: Mrs. Laundrey

Columbus
Miss.
 (mailing address)

WELL LOCATION:
 sec. 24 T. 18 N. R. 17 E.
 S. W.
2 miles N.E. of NEW HOPE
 (distance) (direction) (nearest town)

WELL PURPOSE: Water
 (home, irrigation, municipal, industrial)

WELL COMPLETION DATA:

- (1) diameter (inches) 4
- (2) total depth (feet) 200
- (3) static water level (feet) 70 below above top of ground.
- (4) casing PVC, 103,
 (material) (depth)
 (size) if telescope see back.
- (5) screen _____ (length) _____ (depth to top)
 (size) _____ (material)
- (6) pump 1/2 _____ 10
 (HP) (yield gpm)
E
 (type power)
- (7) electric log no
 (yes or no)
 (organization running log)
- (8) how well bottom plugged open

description of fomations encountered	from	to
<u>sandy clay</u>	<u>0</u>	<u>16</u>
<u>clay</u>	<u>16</u>	<u>22</u>
<u>blue clay</u>	<u>22</u>	<u>105</u>
<u>blue clay & sand streaks</u>	<u>105</u>	<u>200</u>

DRILLERS REMARKS:


DEPT. OF NATURAL RESOURCES
 BUREAU OF LAND & WATER RESOURCES

JUL 14 1982

RECEIVED

If well telescopes please sketch and show depths.

GROUND LEVEL

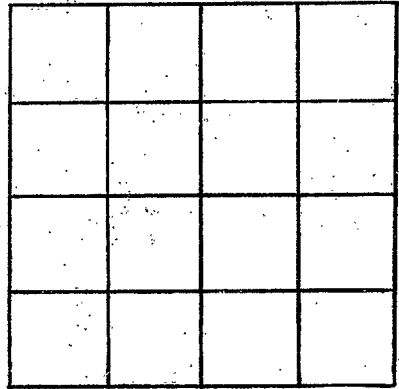

SECTION _____

Please indicate well location X.

ADDITIONAL INFORMATION

If more than one screen, show locations of each on sketch.