

MISSISSIPPI DEPARTMENT OF NATURAL RESOURCES

Bureau of Land and Water Resources

Southport Mall

P.O. Box 10631

Jackson, Mississippi 39209

WATER WELL DRILLERS LOG

Landowner  
K  
2005

8-18 1983 Blardy Well Drilling Landowner  
date well completed firm name county well located

LANDOWNER James Neyman  
Rt 4 Box 365 A  
Columbus, MS  
(mailing address)

WELL LOCATION:  
sec. 10 T 18 R 17 E  
5 miles SE of Colo.  
(distance) (direction) (nearest town)

WELL PURPOSE: home  
(home, irrigation, municipal, industrial)

WELL COMPLETION DATA:

(1) diameter (inches) 4"

(2) total depth (feet) 262'

(3) static water level (feet) 60' below top of ground.

(4) casing PVC 102'  
(material) (depth)  
4" if telescope see back.  
(size)

(5) screen \_\_\_\_\_  
(length) (depth to top)

(size) (material)

(6) pump 1/2 850 gph  
(HP) (yield.gpm)

elec.  
(type power)

(7) electric log no  
(yes or no)

\_\_\_\_\_  
(organization running log)

(8) how well bottom plugged \_\_\_\_\_

description of formations encountered	from	to
grey clay	0	23
blue rock	23	54
sandy clay	54	80
hard blue clay	80	105
gummy clay	105	120
sandy clay	120	124
rock	124	127
hard blue clay	127	160
rock 2"	160	
blue clay	160	183
sand	183	186
sandy clay	186	192
sand	192	196
blue clay	196	201
sandy clay	201	206
blue clay	206	219
sandy clay	219	227
rock 2"		
sandy clay	227	236
sand	236	238
sandy clay	238	244
sand	244	261
blue clay	261	262

DRILLERS REMARKS:  
Pump set 95'


DEPT. OF NATURAL RESOURCES  
BUREAU OF LAND & WATER RESOURCES

SEP 30 1983

RECEIVED

If well telescopes please sketch and show depths.

GROUND LEVEL

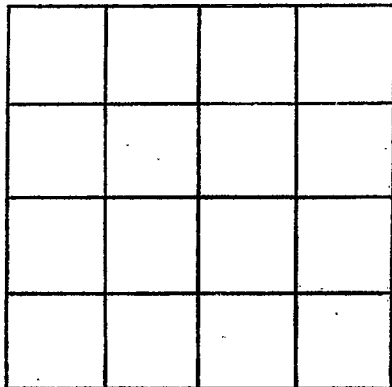

SECTION \_\_\_\_\_

Please indicate well location X.

ADDITIONAL INFORMATION

If more than one screen,  
show locations of each on sketch.