

Lowndes
K
2020

MISSISSIPPI
 BOARD OF WATER COMMISSIONERS
 416 North State Street
 Jackson, Mississippi 39201

WATER WELL DRILLERS LOG

6-19-84 19
 date well completed

Martin S. Robinson
 firm name

Lowndes
 county well located

LANDOWNER: Richard Bryant
Columbus, MS

(mailing address)

WELL LOCATION:

sec. 34 T 18 N R. 17 E
10 miles South of Columbus
 (distance) (direction) (nearest town)

WELL PURPOSE: Home
 (home, irrigation, municipal, industrial)

WELL COMPLETION DATA:

- (1) diameter (inches) 4
- (2) total depth (feet) 240
- (3) static water level (feet) 90 below above top of ground.
- (4) casing PVC, 140'
 (material) (depth)
 (size) if telescope see back.
- (5) screen (length) (depth to top)
 (size) (material)
- (6) pump 3/4 10
 (HP) (yield gpm)
E1
 (type power)
- (7) electric log (yes or no)
 (organization running log)
- (8) how well bottom plugged open

description of formations encountered

from

to

Sand

0 20

Sandy clay

20 80

Blue shale

80 145

Blue shale & sand streaks

145 240

DEPT. OF NATURAL RESOURCES
 BUREAU OF LAND & WATER RESOURCES


DRILLERS REMARKS:

AUG 30 1984

RECEIVED

If well telescopes please sketch and show depths.

GROUND LEVEL

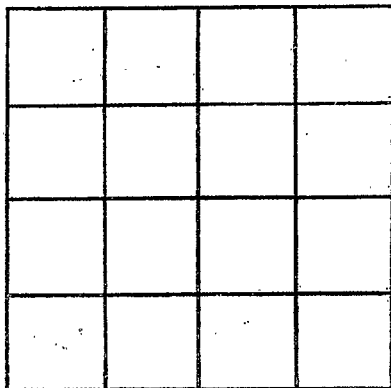

SECTION _____

Please indicate well location X.

ADDITIONAL INFORMATION

If more than one screen, show locations of each on sketch.