

MISSISSIPPI

BOARD OF WATER COMMISSIONERS

416 North State Street

Jackson, Mississippi 39201

WATER WELL DRILLERS LOG

Lowndes  
R 2027

August 22

1984 Mid South Drilling Company

Lowndes

date well completed

firm name

county well located

LANDOWNER: Steve Reichle

Rt. 1 Box 276

Columbus, MS 39701

(mailing address)

description of formations encountered

from

to

clay

0

135

clay and sand

135

330

WELL LOCATION:

sec. 19 T. 18 N.

18 N

R. 17 E

17 E

6

miles NW

of Columbus

(distance)

(direction)

(nearest town)

WELL PURPOSE: home

(home, irrigation, municipal, industrial)

WELL COMPLETION DATA:

(1) diameter (inches) 4"

(2) total depth (feet) 330'

(3) static water level (feet) \_\_\_\_\_ below  
above  
top of ground.

(4) casing PVC 250  
(material) (depth)

back If telescope see back.  
(size)

(5) screen 80' 250'  
(length) (depth to top)

2" .032 PVC  
(size) (material)

(6) pump none  
(HP) (yield-gpm)

(type power)

(7) electric log no  
(yes or no)

none  
(organization running log)

(8) how well bottom plugged screen

DRILLERS REMARKS:

DEPT. OF NATURAL RESOURCES  
BUREAU OF LAND & WATER RESOURCES

OCT - 1 1984  
RECEIVED

If well telescopes please sketch and show depths.


GROUND LEVEL

210'  
4"

40'  
2"

80'  
2"  
.032  
screen

If more than one screen,  
show locations of each on sketch.

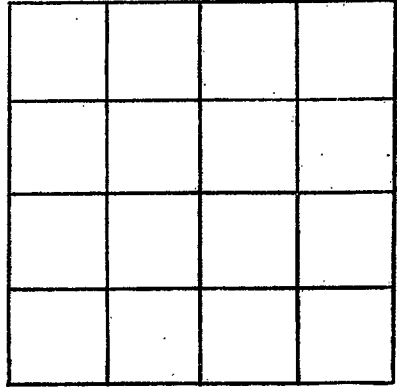

SECTION \_\_\_\_\_

Please indicate well location X.

ADDITIONAL INFORMATION

Lined area for additional information.