

MISSISSIPPI DEPARTMENT OF NATURAL RESOURCES

Bureau of Land and Water Resources

Southport Mall

P.O. Box 10631

Jackson, Mississippi 39209

WATER WELL DRILLERS LOG

Lowndes
K
2028

6/20 19 84 Allsup Drilling, Inc. Lowndes
 date well completed firm name county well located

LANDOWNER: Peach Ella
 TOMMY WALTERS Walters
 RR 1, Box 76
 Crawford, MS 39743
 (mailing address)

description of formations encountered	from	to
Top Soil	0'	2'
Lime Rock	2'	300'
Sand	300'	330'
Muck	330'	350'
Water Sand	350'	520'

WELL LOCATION:
 sec. 30 T 18 N R 17 E
 April 5 miles SE of ARTESIA
 (distance) (direction) (nearest town)

WELL PURPOSE: Home
 (home, irrigation, municipal, industrial)

WELL COMPLETION DATA:

(1) diameter (inches) 4"

(2) total depth (feet) 520'

(3) static water level (feet) 20' below top of ground.

(4) casing PVC (material), (depth)
 4" x 2" if telescope see back. (size)

(5) screen 50' (length), 470' (depth to top)
 2" (size), PVC (material)

(6) pump 1/2 (HP), 25 (yield gpm)
 Electric (type power)

(7) electric log No (yes or no)
 (organization running log)

(8) how well bottom plugged capped

DEPT. OF NATURAL RESOURCES
 BUREAU OF LAND & WATER RESOURCES

DEC - 6 1984

RECEIVED

DRILLERS REMARKS:

If well telescopes please sketch and show depths.


GROUND LEVEL

26' 4" CASING

298' Lime Rock

160' 2" CASING

50' 2" SCREEN

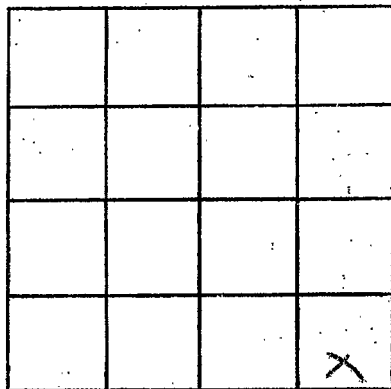

SECTION 30

Please indicate well location X.

ADDITIONAL INFORMATION

If more than one screen, show locations of each on sketch.