

Lowndes
K2029

MISSISSIPPI
BOARD OF WATER COMMISSIONERS
416 North State Street
Jackson, Mississippi 39201

WATER WELL DRILLERS LOG

11/30/81
date well completed

19 Allsup Drilling, Inc.
firm name

Lowndes
county well located

LANDOWNER: Ellis Coan
HWY 45 S.
Columbus, MS 39701
(mailing address)

WELL LOCATION:
sec. 10 T. 18 N R. 12 E
3 3/4 miles S.W of Columbus
(distance) (direction) (nearest town)

WELL PURPOSE: HOME
(home, irrigation, municipal, industrial)

WELL COMPLETION DATA:
(1) diameter (inches) 4"
(2) total depth (feet) 450'
(3) static water level (feet) 55' below
top of ground.
(4) casing PVC Top to bottom
(material) (depth) 450'
4" x 2"
(size) if telescope see back.
(5) screen 80' 370
(length) (depth to top)
2" PVC
(size) (material)
(6) pump 1 1/2 18
(HP) (yield gpm)
Electric
(type power)
(7) electric log No
(yes or no)
(organization running log)
(8) how well bottom plugged capped

description of formations encountered	from	to
<u>Top Soil</u>	<u>0</u>	<u>10</u>
<u>Soft Fine Rock</u>	<u>10</u>	<u>120</u>
<u>Sand</u>	<u>120</u>	<u>140</u>
<u>Muck</u>	<u>140</u>	<u>200</u>
<u>Gravel + Sand</u>	<u>200</u>	<u>370</u>
<u>Water Sand</u>	<u>370</u>	<u>450</u>

DEPT. OF NATURAL RESOURCES
BUREAU OF LAND & WATER RESOURCES

DEC - 6 1984
RECEIVED


If well telescopes please sketch and show depths.

GROUND LEVEL

120'
4" casing

250'
2" casing

80'
2" Screen

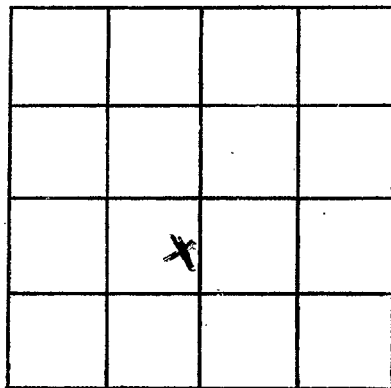

SECTION 10

Please indicate well location X.

ADDITIONAL INFORMATION

Lined area for additional information.