

MISSISSIPPI DEPARTMENT OF NATURAL RESOURCES

Bureau of Land and Water Resources

Southport Mall

P.O. Box 10631

Jackson, Mississippi 39209

WATER WELL DRILLERS LOG

LOWNDES
K 2033

8-24-87 19 Mid South Drilling Company Lowndes
date well completed firm name county well located

LANDOWNER: Fred Sobley Rt. 8 Box 293 Columbus, MS 39701 (mailing address)	description of formations encountered	from	to	
WELL LOCATION: sec. <u>21</u> T <u>19</u> R <u>17</u> E 8 miles SSE of Columbus (distance) (direction) (nearest town)	sand	0	2	
	clay	2	4	
	sandy red clay	4	20	
	sand	20	27	
	sand & gravel	27	37	
	clay	37	140	
	clay w/sand streaks	140-150		
	sand	150	170	
	clay	170	223	
	WELL PURPOSE: home (home, irrigation, municipal, industrial)	sand	223	231
WELL COMPLETION DATA: (1) diameter (inches) <u>4</u> (2) total depth (feet) <u>300</u> (3) static water level (feet) <u>122</u> below top of ground. 300 (4) casing <u>PVC</u> , <u>150'</u> (material) (depth) <u>4"</u> if telescope see back. (size) (5) screen <u>none</u> (length) (depth to top) (size) (material) (6) pump <u>3/4</u> <u>12</u> (HP) (yield gpm) <u>electric</u> (type power) (7) electric log <u>no</u> (yes or no) <u>no</u> (organization running log) (8) how well bottom plugged <u>open</u>	clay	231	240	
	clay w/ sand streaks	240	257	
	clay	257	260	
	sand	260	265	
	clay w/ sand streaks	265	277	
	sand	277	290	
	sand w/ clay streaks	290	300	
		rock at 147, 208, 212		
DRILLERS REMARKS:				


RECEIVED

SEP 30 1987

Department of Natural Resources
Bureau of Land & Water Resources

If well telescopes please sketch and show depths.

GROUND LEVEL

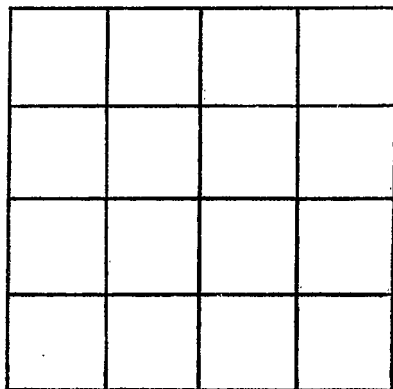

SECTION _____

Please indicate well location X.

ADDITIONAL INFORMATION

If more than one screen,
show locations of each on sketch.