

Lowndes
L
8-9-76

MISSISSIPPI
 BOARD OF WATER COMMISSIONERS
 416 North State Street
 Jackson, Mississippi 39201

WATER WELL DRILLERS LOG

8-9 1976 W. T. REEVES & SON LOWNDES
 date well completed firm name county well located

LANDOWNER: PETE O'BRYANT
RT. 4
COLUMBUS
 (mailing address)

WELL LOCATION:
 sec. 3 T. 18 N. R. 18 E
3 miles SO of COLUMBUS
 (distance) (direction) (nearest town)

WELL PURPOSE: HOME
 (home, irrigation, municipal, industrial)

WELL COMPLETION DATA:

(1) diameter (inches) 4

(2) total depth (feet) 120

(3) static water level (feet) 8 below above top of ground.

(4) casing STEEL 23 1/2
 (material) (depth)
4 If telescope see back.
 (size)

(5) screen _____
 (length) (depth to top)
 (size) (material)

(6) pump 1/2 7
 (HP) (yield gpm)
ELECT
 (type power)

(7) electric log NO
 (yes or no)
 (organization running log)

(8) how well bottom plugged OPEN

description of formations encountered	depth	
	from	to
CLAY	0	14
SAND & GRAVEL	14	20
BLUE CLAY	20	45
1" SAND	45	56
1" CLAY	56	64
1" SAND	64	82
1" CLAY	82	94
1" SAND	94	120


RECEIVED
 APR 12 1977

DRILLERS REMARKS:

MISS. BD. OF WATER COMMISSIONERS

If well telescopes please sketch and show depths.

GROUND LEVEL

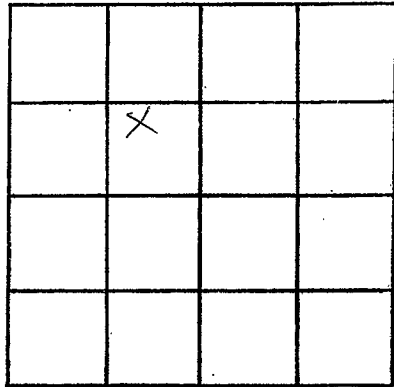

SECTION 3

Please indicate well location X.

ADDITIONAL INFORMATION

If more than one screen,
show locations of each on sketch.