

LOWNDES

MISSISSIPPI BOARD OF WATER COMMISSIONERS

L

8-63

WATER WELL DRILLERS LOG

Date: Aug, 1963, Driller: W B Clardy County: Lowndes

12056

(Name)

(1) Owner of Land: Nelson E. Kin

(Name)

Columbus

(Address)

(2) Location: 1/4, 1/4, Sec. 3, T18R18W

7

(distance)

S

(direction)

of Celo

(Nearest Town)

(3) Topography: Level

(Hilly)

(Flat)

(Level)

(4) Purpose of Well: Domestic

(Domestic Irrigation
Municipal, Industrial, Other)

Description & Color of Materials
Sand, Clay, Red Clay, Shell, etc.

Thick-
ness
Feet

Depth
Feet

Sand + Gravel 8-25
Blue Clay 25-125
Sand 125-135
Sandy Strata 135-210

Information upon completion of well:

(1) Diameter 4 inches.

(2) Total Depth 210 feet.

(3) Water Level 8 feet below top of ground.

(4) Cased to 63, Size 4"

(5) Screen: Size, Length


(6) Were any formations sealed against pollution?

yes, no.

If YES depth of formation

Why

Drillers Remarks:

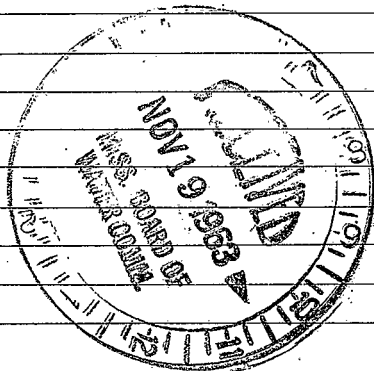

(Use Back Side)

Well No.

