

CODED

Lowndes
L30
9-12-68

MISSISSIPPI
BOARD OF WATER COMMISSIONERS
416 North State Street
Jackson, Mississippi 39201

CODED

WATER WELL DRILLERS LOG

9-12 1968 W. J. REEVES & SON Lowndes
date well completed firm name county well located

LANDOWNER: TREWEN SHEFFIELD

description of formations encountered

from to

RT. 4 Nashville Tenn. Rd.
COLUMBUS, MISS-
(mailing address)

CLAY	0	12
SAND & GRAVEL	12	34
BLUE CLAY	34	77
" SAND	77	89
" CLAY	89	107
" SAND	107	122
" CLAY	122	127
" SAND	127	135

WELL LOCATION:

sec. 3 T19 R18 S
3 miles S of COLUMBUS
(distance) (direction) (nearest town)

WELL PURPOSE: HOME
(home, irrigation, municipal, industrial)

WELL COMPLETION DATA:

- (1) diameter (inches) 4
- (2) total depth (feet) 135
- (3) static water level (feet) 24 below top of ground.
- (4) casing STEEL, 42' (material) (depth)
4 (size) If telescope see back.
- (5) screen NONE (length) (depth to top)
(size) (material)
- (6) pump 1/2 (HP) 7 (yield gpm)
ELECT (type power)
- (7) electric log NO (yes or no)
(organization running log)
- (8) how well bottom plugged OPEN

CODED


JAN 10 1968

DRILLERS REMARKS:

MISS. Bd. OF WATER COMM.

If well telescopes please sketch and show depths.

GROUND LEVEL

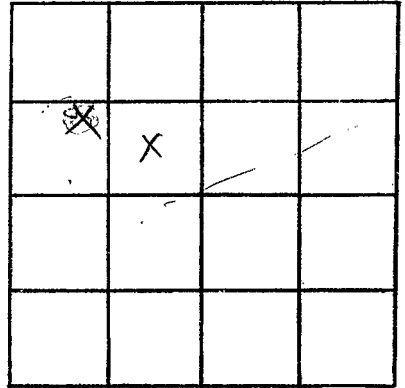

SECTION 3

Please indicate well location X.

ADDITIONAL INFORMATION

If more than one screen, show locations of each on sketch.