

Lowndes
 L31
 7-11-69


CODED
 MS-GW-3211 and request 12/29/69
 8/8/69
 MISSISSIPPI
 BOARD OF WATER COMMISSIONERS
 416 North State Street
 Jackson, Mississippi 39201
 WATER WELL DRILLERS LOG
 CODED

7-11-1969 Layne-Central Co. Lowndes
 date well completed firm name county well located

LANDOWNER:
 Eka Chemicals
 Hooker Chemical Company

description of formations encountered	from	to
Clay	0	3
Gravel	8	32
Hard clay & rock	32	312
Sand & clay	312	334
Gumbo & rock	334	526
Sand & gravel	526	572
Hard gumbo & rock	572	835
Sand & gravel	835	951
Gumbo	951	960

Columbus, Mississippi
 (mailing address)

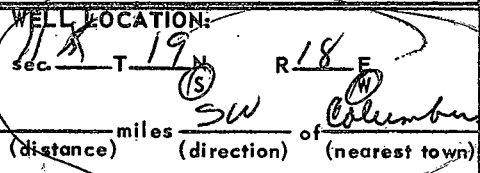

WELL PURPOSE: Industrial
 (home, irrigation, municipal, industrial)

- WELL COMPLETION DATA:
- (1) diameter (inches) 16"
 - (2) total depth (feet) 954'
 - (3) static water level (feet) 4' below top of ground.
 - (4) casing steel, 883' (material), (depth), 16" (size) If telescope see back.
 - (5) screen 60', 888' (length), (depth to top), 10" stainless shutter (size), (material)
 - (6) pump 125 (HP), 1500 (yield gpm), electric (type power)
 - (7) electric log (yes or no)
 (organization running log)
 - (8) how well bottom plugged


DRILLERS REMARKS:

AUG 8 1969
 MISS. BD. OF WATER



If well telescopes please sketch and show depths.

GROUND LEVEL

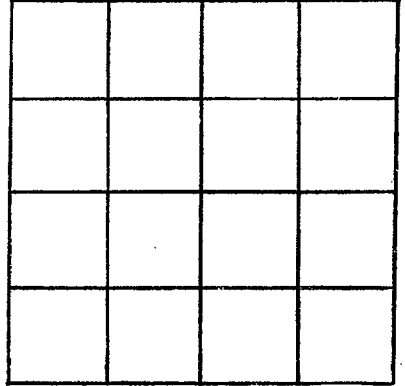

SECTION _____

Please indicate well location X.

ADDITIONAL INFORMATION

If more than one screen, show locations of each on sketch.