

Coded

MISSISSIPPI  
BOARD OF WATER COMMISSIONERS  
416 North State Street  
Jackson, Mississippi 39201

WATER WELL DRILLERS LOG

Lowndes

L 33

G-68

June 25, 1968 Layne-Central Co.  
date well completed firm name

Lowndes  
county well located

LANDOWNER: Hooker Chemical  
Company,  
Columbus, Mississippi

description of formations  
encountered

from to

(mailing address)

WELL LOCATION:

sec. 10 T 19 N R 18 E  
(S) (W)

\_\_\_\_\_ miles \_\_\_\_\_ of \_\_\_\_\_  
(distance) (direction) (nearest town)


WELL PURPOSE: Industrial  
(home, irrigation, municipal, industrial)

WELL COMPLETION DATA:

- (1) diameter (inches) 16"
- (2) total depth (feet) 954'
- (3) static water level (feet) flowing <sup>below</sup>/<sub>above</sub> top of ground.
- (4) casing S. S. 883'  
(material) (depth)  
16" if telescope see back.  
(size)
- (5) screen 60' 887'  
(length) (depth to top)  
10" s. s. shutter  
(size) (material)
- (6) pump 125 1500  
(HP) (yield gpm)  
electric  
(type power)
- (7) electric log \_\_\_\_\_  
(yes or no)  
\_\_\_\_\_  
(organization running log)
- (8) how well bottom plugged \_\_\_\_\_

Clay 0-7  
sand & gravel 7-41  
Gumbo & rock st 41-120  
clay, sand st.  
& boulders 120-215  
hard gumbo 215-338  
sand & shale 338-358  
gumbo & rock st 358-527  
sand & gravel 527-600  
hard clay 600-658  
shale-sand st 658-698  
gumbo-rock st 698-853  
sand-gravel 853-874  
rock 874-876  
hard clay 876-884  
sand-gravel 884-950  
hard gumbo 950-962

Total Depth 954'

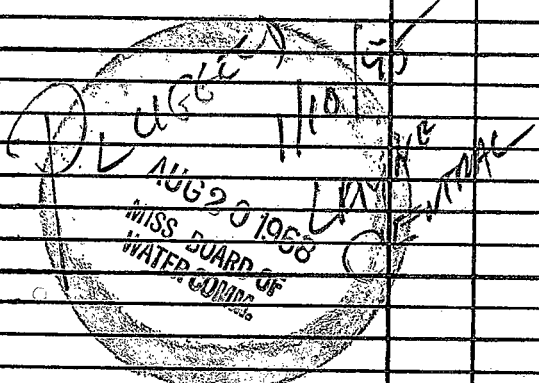

DRILLERS REMARKS:



If well telescopes please sketch and show depths.

GROUND LEVEL

		X	

SECTION \_\_\_\_\_

Please indicate well location X.

ADDITIONAL INFORMATION

If more than one screen, show locations of each on sketch.