

LOWNDES MISSISSIPPI BOARD OF WATER COMMISSIONERS

6 L41 MS-60-3209

4-15-64

WATER WELL DRILLERS LOG

Date: 4-15-64 ~~19~~, Driller: Layne-Central Co. County: Lowndes

EKA Chemicals (Name)

(1) Owner of Land: Hooker Chem. Corp.
(Name)
Columbus, Miss.

(2) Location: NW 1/4, SE 1/4, Sec 10 T 195 R 16W
(Address)
_____ miles _____ of _____
(distance) (direction) (Nearest Town)

(3) Topography: _____
(Hilly) (Flat) (Level)

(4) Purpose of Well: industrial
(Domestic Irrigation
Municipal, Industrial, Other)


Information upon completion of well:

- (1) Diameter 16 inches.
- (2) Total Depth 968 feet.
- (3) Water Level 29' 5" head feet below top of ground.
- (4) Cased to 893', Size 16"
- (5) Screen: Size 10", Length 60'
- (6) Were any formations sealed against pollution?
X yes, _____ no.

If YES depth of formation 893'
Why _____ required

Drillers Remarks: _____

Description & Color of Materials Sand, Clay, Red Clay, Shell, etc.	Thick- ness Feet	Depth Feet
total depth		
968'		
0-8	clay	
8-34	sand-gravel	
34-85	shale	
85-250	sandy shale-bldrs.	
250-325	Hard clay	
325-352	sand	
352-456	tough clay	
456-483	sand	
483-492	clay	
492-495	rock	
495-504	clay	
504-593	sand-gravel	
593-620	hard clay	
620-683	shale-sandy st.	
683-860	hard gumbo & boulders	
860-972	sand-gravel	

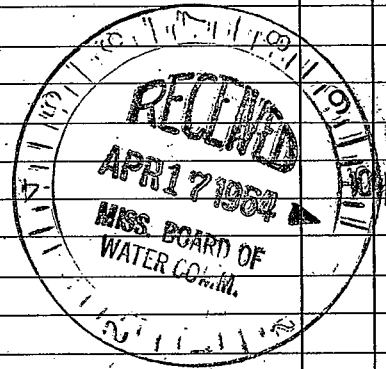

(Use Back Side)

Well No.

(4)