

**LOWNDES**  
**L 44**  
**11-2-72**

MISSISSIPPI  
 BOARD OF WATER COMMISSIONERS  
 416 North State Street  
 Jackson, Mississippi 39201

**CODED**

**WATER WELL DRILLERS LOG**

No. 2 19 31 Clay, silt + pump Sew. Lowndes  
 date well completed firm name county well located

LANDOWNER: R. L. Price  
Rt. 6 Box 324  
Columbus Miss.  
 (mailing address)

WELL LOCATION:  
 sec. 15 T 19 N R 18 W  
S W  
5 miles South of Columbus  
 (distance) (direction) (nearest town)

WELL PURPOSE: Camp house  
 (home, irrigation, municipal, industrial)

WELL COMPLETION DATA:

(1) diameter (inches) 4"

(2) total depth (feet) 165

(3) static water level (feet) 1' ~~below~~ above top of ground.

(4) casing steel, 52',  
 (material) (depth)  
 (size) if telescope see back.

(5) screen \_\_\_\_\_  
 (length) (depth to top)  
 (size) (material)

(6) pump \_\_\_\_\_  
 (HP) (yield gpm)  
 (type power)

(7) electric log \_\_\_\_\_  
 (yes or no)  
 (organization running log)

(8) how well bottom plugged \_\_\_\_\_

description of formations encountered	from	to
sand	0	5
clay	5	12
sand + gravel	12	20
blue clay	20	60
sandy clay	60	69
blue clay	70	90
sandy clay	90	102
rocks	102	103
sandy clay	103	125
sand	125	165

**CODED**


NOV - 8 1972

DRILLERS REMARKS: No Pump installed by driller

If well telescopes please sketch and show depths.



GROUND LEVEL

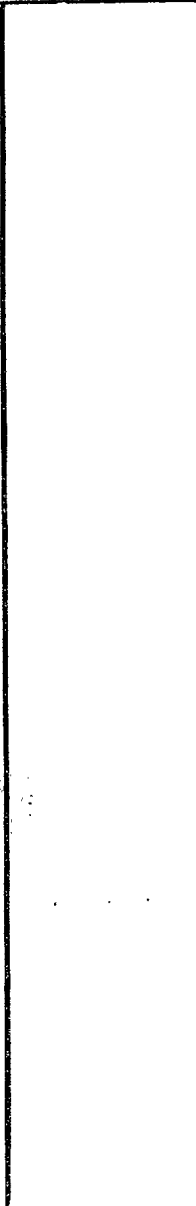

If more than one screen, show locations of each on sketch.

			X

SECTION 15

Please indicate well location X.

ADDITIONAL INFORMATION

Lined area for additional information.