

**LOWNDES**  
**L47**  
**1-16-74**

MISSISSIPPI  
 BOARD OF WATER COMMISSIONERS **CODED**  
 416 North State Street  
 Jackson, Mississippi 39201

**WATER WELL DRILLERS LOG**

1-16 1974 Albany Drilling Co. Lowndes County  
 date well completed firm name county well located

LANDOWNER: American Busch  
Columbus, Miss  
 (mailing address)

description of formations encountered	from	to
Top Soil	0	14
Blue Rock	14	97
Sand	97	208
Muck	208	261
Sand	261	374

WELL LOCATION:  
 sec. 23 T 18 N R 18 E  
In city limits of Columbus  
 (distance) miles (direction) (nearest town)

**CODED**

WELL PURPOSE: Irrigation Town  
 (home, irrigation, municipal, industrial)

- WELL COMPLETION DATA:
- (1) diameter (inches) 6" x 4"
  - (2) total depth (feet) 374
  - (3) static water level (feet) 32 below above top of ground.
  - (4) casing Plastic, 190'  
 (material) (depth)  
6" if telescope see back.  
 (size)
  - (5) screen 60', 314'  
 (length) (depth to top)  
4", Plastic  
 (size) (material)
  - (6) pump 15, 150  
 (HP) (yield gpm)  
Electric  
 (type power)
  - (7) electric log No  
 (yes or no)
  - (8) how well bottom plugged Cap


DRILLERS REMARKS:

MISS. D. ...

(A)

If well telescopes please sketch and show depths.


GROUND LEVEL

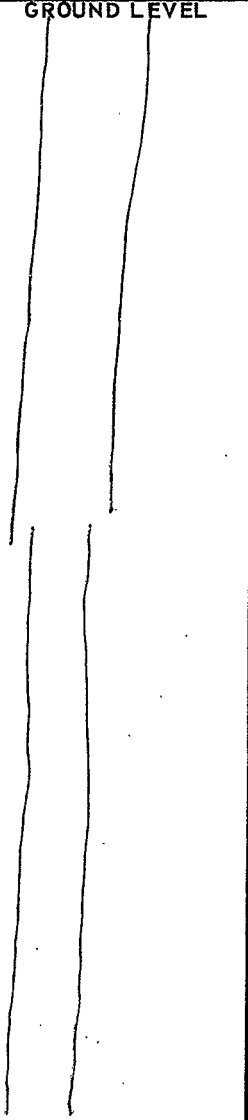

190'  
6" casing

124'  
4" casing

60' 4" Screen

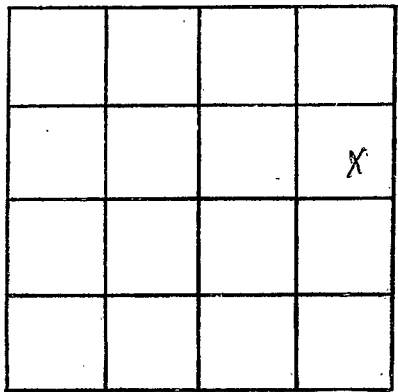

SECTION 23

Please indicate well location X.

ADDITIONAL INFORMATION

A series of horizontal lines for additional information.

If more than one screen, show locations of each on sketch.