

LOWNDES

L 48

7-3-74

MISSISSIPPI
 BOARD OF WATER COMMISSIONERS
 416 North State Street
 Jackson, Mississippi 39201

CODED

WATER WELL DRILLERS LOG

July 3 1974
date well completed

Clardy Well Pump
firm name

Lowndes
county well located

LANDOWNER: Charlie Beckwith

Nashville Ferry Rd.
 Columbus, Miss.
 (mailing address)

description of formations encountered

from

to

brown clay	0	15
sand + gravel	15	45
sandy blue clay	45	55
blue clay	55	95
fine sand	95	105
streaks fine sand + clay	95	105
fine sand	105	145
course sand	145	175

WELL LOCATION:

sec. 23 T 19 N R 18 E
 8 miles S of Cal
 (distance) (direction) (nearest town)

WELL PURPOSE: home
(home, irrigation, municipal, industrial)

WELL COMPLETION DATA:

- (1) diameter (inches) 4
- (2) total depth (feet) 175
- (3) static water level (feet) 9 below
top of ground.
- (4) casing 4" steel, 58
(material) (depth)
- _____ if telescope see back.
(size)
- (5) screen _____
(length) (depth to top)
- _____ (size) _____ (material)
- (6) pump _____ (HP) _____ (yield gpm)
- _____ (type power)
- (7) electric log _____
(yes or no)
- _____ (organization running log)
- (8) how well bottom plugged _____


CODED

RECEIVED
JUL 22 1974

DRILLERS REMARKS: Customer installed own Pump

If well telescopes please sketch and show depths.

GROUND LEVEL

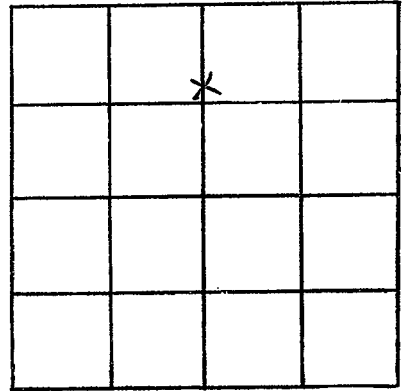

SECTION 23

Please indicate well location X.

ADDITIONAL INFORMATION

If more than one screen,
show locations of each on sketch.