

LOWNDES
L50
9-15-75

MISSISSIPPI
 BOARD OF WATER COMMISSIONERS
 416 North State Street
 Jackson, Mississippi 39201

CODED

WATER WELL DRILLERS LOG

4/15 1975 Norman Elkh Lowndes
 date well completed firm name county well located

LANDOWNER: John Wootley Jr.
R70 #
Columbus, Miss
 (mailing address)

description of formations encountered	from	to
<u>Sandy clay</u>	<u>0</u>	<u>18</u>
<u>(cherty)</u>	<u>18</u>	<u>200</u>
<u>Sand & clay</u>	<u>200</u>	<u>525</u>

WELL LOCATION:
 sec 31 T 18 N R 18 E
7 miles South of Columbus
 (distance) (direction) (nearest town)

WELL PURPOSE: None
 (home, irrigation, municipal, industrial)


- WELL COMPLETION DATA:
- (1) diameter (inches) 5
 - (2) total depth (feet) 525
 - (3) static water level (feet) 120 below above top of ground.
 - (4) casing 21' 5" Steel
 (material) (depth)
 (size) if telescope see back.
 - (5) screen _____
 (length) (depth to top).
 (size) (material)
 - (6) pump 1/2 9
 (HP) (y/field gpm)
Electric
 (type power)
 - (7) electric log _____
 (yes or no)
 (organization running log)
 - (8) how well bottom plugged 0

DRILLERS REMARKS:
200 top 525
Sand has 3 operations
with cherty clay

RECEIVED
 MAY 19 1975
 MISS. BD. OF WATER

If well telescopes please sketch and show depths.

GROUND LEVEL

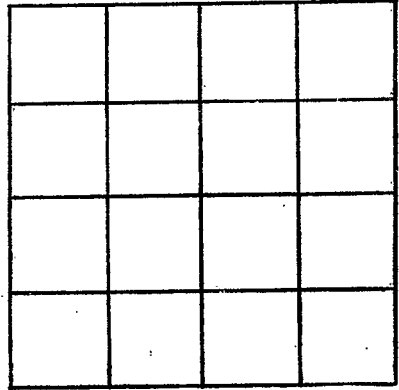

SECTION _____

Please indicate well location X.

ADDITIONAL INFORMATION

If more than one screen, show locations of each on sketch.