

LOWMEDES
L 2006
12-9-80

MISSISSIPPI
BOARD OF WATER COMMISSIONERS
416 North State Street
Jackson, Mississippi 39201

WATER WELL DRILLERS LOG

12-9-80 date well completed
1980 Mark S. Ridgeway firm name
Lowmedes county well located

LANDOWNER: Dennis Hollimon
Hughes Rd.
Columbus MS, 39701
(mailing address)

description of formations encountered

from to

WELL LOCATION:
sec. 13 T-19 N R-18 W
5 miles S.E. of Columbus
(distance) (direction) (nearest town)

Brown clay	0	13
Gravel	15	49
Blue shale + sand streaks	49	150
Sand streaks	150	170
Blue shale	170	190
Sand	190	194
Blue shale	194	200

WELL PURPOSE: none
(home, irrigation, municipal, industrial)

WELL COMPLETION DATA:
(1) diameter (inches) 4"
(2) total depth (feet) 200'
(3) static water level (feet) 30 below top of ground.
(4) casing 80' PVC (material) 80' (depth)
(size) if telescope see back.
(5) screen (length) (depth to top) (size) (material)
(6) pump 3/4 (HP) 10 (yield gpm)
E (type power)
(7) electric log 200 (yes or no)
(organization running log)
(8) how well bottom plugged open

DEPT. OF NATURAL RESOURCES
BUREAU OF LAND & WATER RESOURCES


JAN 5 1981

RECEIVED

DRILLERS REMARKS:

If well telescopes please
sketch and show depths.

GROUND LEVEL

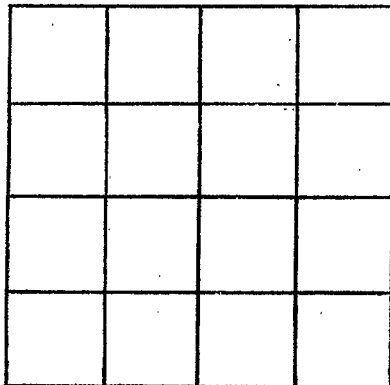

SECTION _____

Please indicate well location X.

ADDITIONAL INFORMATION

If more than one screen,
show locations of each on sketch.