

MISSISSIPPI DEPARTMENT OF NATURAL RESOURCES

Bureau of Land and Water Resources

Southport Mall

P.O. Box 10631

Jackson, Mississippi 39209

WATER WELL DRILLERS LOG

Lowndes
W 2007
12-24-80
12-24

date well completed

firm name

county well located

1980 Clardy Well Drilling Lowndes

LANDOWNER: Joh W Hollinger
Stennis, Miss.

description of formations encountered

from

to

(mailing address)

WELL LOCATION

sec. 2 T. 18 N. R. 18 W.
3 1/2 miles So. of Colw.
(distance) (direction) (nearest town)

WELL PURPOSE:

(home, irrigation, municipal, industrial)

WELL COMPLETION DATA:

- (1) diameter (inches) 4"
- (2) total depth (feet) 132'
- (3) static water level (feet) 14' below/above top of ground.
- (4) casing PVC, 65'
(material) (depth)
(size) if telescope see back.
- (5) screen d
(length) (depth to top)
(size) (material)
- (6) pump 1/2 500 gpm
(HP) (yield gpm)
Elec.
(type power)
- (7) electric log no
(yes or no)
(organization running log)
- (8) how well bottom plugged

Sand & Gravel	10'	30'
Clay	30	36
Rock's	56	58
Clay	58	66
Rock	66	67
Clay	67	70
Rock	70	76
Sandy Clay	76	83
Sand	83	87
Streaks of Sand	87	95
Sand	95	97
Sandy clay	97	100
Rock	100	
Sandy clay	100	110
Rock	110	
Sand	110	115
Rock	115	
Sand	115	122
Rock	122	
Sandy clay	122	130
Rock	130	131
Clay	132	

DEPT. OF NATURAL RESOURCES
BUREAU OF LAND & WATER RESOURCES


JAN 9 1981

RECEIVED

DRILLERS REMARKS:

If well telescopes please
sketch and show depths.

GROUND LEVEL

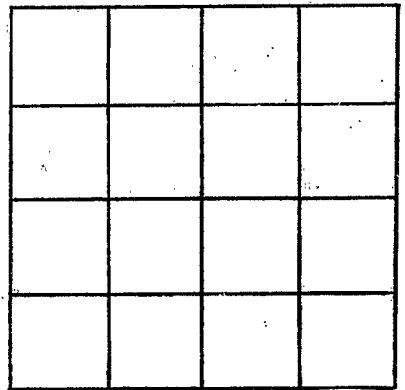

SECTION _____

Please indicate well location X.

ADDITIONAL INFORMATION

If more than one screen,
show locations of each on sketch.