

LOWNDES  
L 2008  
10-12-81

MISSISSIPPI  
BOARD OF WATER COMMISSIONERS  
416 North State Street  
Jackson, Mississippi 39201

WATER WELL DRILLERS LOG

10-12 date well completed 1981 firm name *Martin S. Kibbey* county well located *Lowndes*

LANDOWNER: *Jane Bates*  
*Calumbees, MS*  
*Highway 69 South*  
(mailing address)

WELL LOCATION:  
sec. *24* T. *19S* R. *18W*  
*5* miles *South* of *Calumbees*  
(distance) (direction) (nearest town)

WELL PURPOSE: *2nd use*  
(home, irrigation, municipal, industrial)

- WELL COMPLETION DATA:
- (1) diameter (inches) *4"*
  - (2) total depth (feet) *188'*
  - (3) static water level (feet) *25'* below top of ground
  - (4) casing *PVC* *83'*  
(material) (depth)  
*5"* If telescope see back.  
(size)
  - (5) screen  
(length) (depth to top)  
(size) (material)
  - (6) pump *1/2* *10*  
(HP) (yield gpm)  
*E1*  
(type power)
  - (7) electric log *NO*  
(yes or no)  
(organization running log)
  - (8) how well bottom plugged *off*


description of formations encountered	from	to
<i>clay</i>	<i>15</i>	<i>15</i>
<i>sand &amp; gravel</i>	<i>15</i>	<i>27</i>
<i>clay</i>	<i>27</i>	<i>32</i>
<i>gravel</i>	<i>32</i>	<i>34</i>
<i>blue shale</i>	<i>34</i>	<i>90</i>
<i>blue shale &amp; sand streaks</i>	<i>90</i>	<i>140</i>
<i>blue shale</i>	<i>140</i>	<i>145</i>
<i>sand streaks</i>	<i>145</i>	<i>188</i>

DRILLERS REMARKS:

DEPT. OF NATURAL RESOURCES  
BUREAU OF LAND & WATER RESOURCES  
NOV 30 1981  
RECEIVED

If well telescopes please sketch and show depths.

GROUND LEVEL

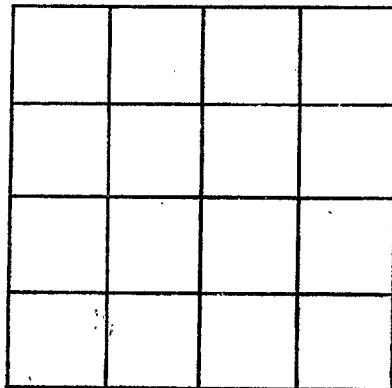

SECTION \_\_\_\_\_

Please indicate well location X.

ADDITIONAL INFORMATION

A series of horizontal lines for entering additional information.

If more than one screen, show locations of each on sketch.