

MISSISSIPPI DEPARTMENT OF NATURAL RESOURCES

Bureau of Land and Water Resources

Southport Mall

P.O. Box 10631

Jackson, Mississippi 39209

WATER WELL DRILLERS LOG

LOWNDES
L 2010

6-11-84 19 *Clardy Well Drilling Lowndes*
date well completed firm name county well located

LANDOWNER: *Russell Sheffield*
Nashville Ferry Rd
Columbus, MS
(mailing address)

WELL LOCATION:
sec. *15* T. *19* N. R. *18* W.
5 miles *So.* of *Colo.*
(distance) (direction) (nearest town)

WELL PURPOSE: *Home*
(home, irrigation, municipal, industrial)

WELL COMPLETION DATA:

(1) diameter (inches) 4"

(2) total depth (feet) 242'

(3) static water level (feet) 2 1/2' below top of ground.

(4) casing PVC 105'
(material) (depth)
 If telescope see back.
(size)

(5) screen (length) (depth to top)
(size) (material)

(6) pump 1/2 900 gphs.
(HP) (yield gpm)
elec
(type power)

(7) electric log no
(yes or no)

(organization running log)

(8) how well bottom plugged

description of formations encountered	depth	
	from	to
brown clay	0	17
sand & gravel	17	20
"blue" clay	20	71
sandy clay	71	72
red clay	72	75 1/2
hard clay	75 1/2	106
sand clay	106	153
sand	153	159
sandy clay	159	163
rock	163	172
hard clay	172	183
sand & rock	183	184
hard clay	184	197
sandy clay	197	206 1/2
rock 6"	206 1/2	207
hard clay	207	219
sand	219	222 1/2
rock 6"	222 1/2	224
sand	224	242


DEPT. OF NATURAL RESOURCES
BUREAU OF LAND & WATER RESOURCES

JUL 11 1984
RECEIVED

DRILLERS REMARKS:

If well telescopes please sketch and show depths.

GROUND LEVEL

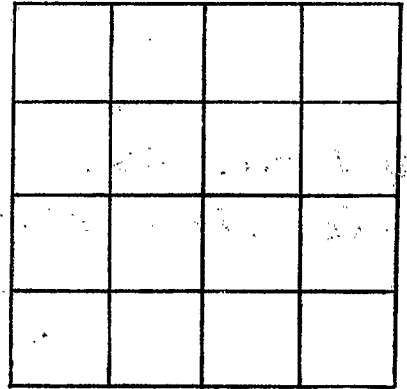

SECTION _____

Please indicate well location X.

ADDITIONAL INFORMATION

If more than one screen,
show locations of each on sketch.