

MISSISSIPPI DEPARTMENT OF NATURAL RESOURCES

Bureau of Land and Water Resources

Southport Mall

P.O. Box 10631

Jackson, Mississippi 39209

WATER WELL DRILLERS LOG

Lowndes  
L-201

8-14/84 19 Clardy Well Drilling Lowndes  
date well completed firm name county well located

LANDOWNER: Ronnie West  
720 Lehman Rd  
Columbus, Miss.  
(mailing address)

WELL LOCATION:  
sec. 15 T. 19 N. R. 18 W.  
5 miles So. of Col.  
(distance) (direction) (nearest town)

WELL PURPOSE: camp house  
(home, irrigation, municipal, industrial)

WELL COMPLETION DATA:

- (1) diameter (inches) 4"
- (2) total depth (feet) 143'
- (3) static water level (feet) 12' below above top of ground.
- (4) casing PVC 61'  
(material) (depth)  
         if telescope see back.  
(size)
- (5) screen          (length) (depth to top)  
(size) (material)
- (6) pump 1/2 900 gph  
(HP) (yield gph)  
elec.  
(type power)
- (7) electric log no  
(yes or no)  
          
(organization running log)
- (8) how well bottom plugged

description of formations encountered	from	to
<u>red clay</u>	<u>0</u>	<u>8</u>
<u>sand &amp; gravel</u>	<u>8</u>	<u>26</u>
<u>blue clay</u>	<u>26</u>	<u>34</u>
<u>sandy clay</u>	<u>34</u>	<u>75</u>
<u>hard clay</u>	<u>75</u>	<u>78</u>
<u>sandy clay</u>	<u>78</u>	<u>81</u>
<u>rock 6"</u>		
<u>gravel</u>	<u>81 1/2</u>	<u>88</u>
<u>blue clay</u>	<u>88</u>	<u>117</u>
<u>hard clay</u>	<u>117</u>	<u>146</u>
<u>clay</u>	<u>146</u>	<u>148</u>

DEPT. OF NATURAL RESOURCES  
BUREAU OF LAND & WATER RESOURCES


SEP 25 1984

RECEIVED

DRILLERS REMARKS:

If well telescopes please sketch and show depths.

GROUND LEVEL

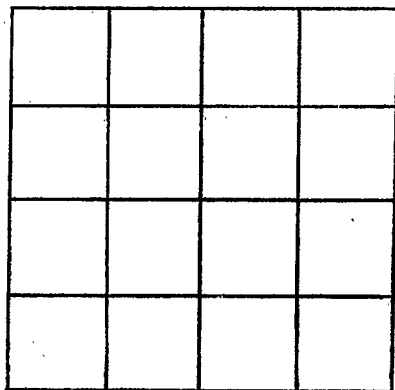

SECTION \_\_\_\_\_

Please indicate well location X.

ADDITIONAL INFORMATION

If more than one screen,  
show locations of each on sketch.