

MISSISSIPPI DEPARTMENT OF NATURAL RESOURCES

Bureau of Land and Water Resources

Southport Mall

P.O. Box 10631

Jackson, Mississippi 39209

WATER WELL DRILLERS LOG

LOWNDES

L 2012

5-15-85 19
date well completed

Clardy Well Drilling Loundes
firm name

county well located

LANDOWNER: Christina Rice

description of formations encountered

from

to

Rt 8 Box 418

Colo. 7ms.
(mailing address)

Red Clay	0	10
sand & gravel	10	37
good. blue clay	37	88
sandy clay	88	114
sand	114	138
sandy clay	138	148
hard clay	148	150

WELL LOCATION:

sec. 10 T 17 N R 18
4 miles S of Colo.
(distance) (direction) (nearest town)

WELL PURPOSE: None
(home, irrigation, municipal, industrial)

WELL COMPLETION DATA:

- (1) diameter (inches) 4"
- (2) total depth (feet) 150'
- (3) static water level (feet) 23 below above top of ground.
- (4) casing PVC, 75'
(material) (depth)
4"
(size) If telescope see back.
- (5) screen _____
(length) (depth to top)
(size) (material)
- (6) pump 1/2 900 gph
(HP) (yield gpm)
elec.
(type power)
- (7) electric log no
(yes or no)

(organization running log)

(8) how well bottom plugged _____


DRILLERS REMARKS:

RECEIVED
JUN 21 1985

Department of Natural Resources
Bureau of Land & Water Resources

If well telescopes please sketch and show depths.

GROUND LEVEL

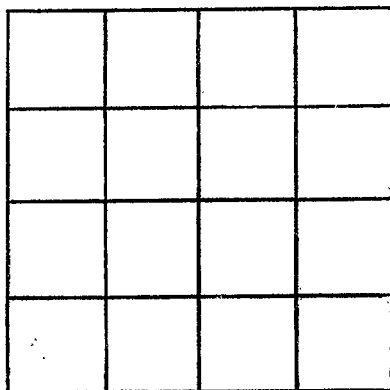

SECTION _____

Please indicate well location X.

ADDITIONAL INFORMATION

If more than one screen,
show locations of each on sketch.