

MISSISSIPPI DEPARTMENT OF NATURAL RESOURCES
Bureau of Land and Water Resources
 Southport Mall
 P.O. Box 10631
 Jackson, Mississippi 39209
WATER WELL DRILLERS LOG

LOWNDES

L 2013

715185

7/5/85
 date well completed

Clardy Well Drilling Lowndes
 firm name

county well located

LANDOWNER: John Holliman

description of formations encountered

from

to

Rt. 1

sand & gravel 0 38

Stems, Ms.

sandy blue clay 38 51

(mailing address)

blue clay 51 52

WELL LOCATION:

sandy - rocky 52 60 1/2

sec. 7 T. 18 N. R. 18 E.

sandy 60 1/2 74

4 miles SW of Colo.
 (distance) (direction) (nearest town)

rock 74 74

WELL PURPOSE: home
 (home, irrigation, municipal, industrial)

sandy clay 74 93 1/2

WELL COMPLETION DATA:

blue clay 93 1/2 94

(1) diameter (inches) 4"

sandy clay 94 107

(2) total depth (feet) 255

sandy clay 107 107

(3) static water level (feet) 16 below
 top of ground. above

hard blue clay 107 142

(4) casing PVC, 72'
 (material) (depth)

sandy clay 142 154

4" if telescope see back.
 (size)

sandy clay 154 163

(5) screen 30',
 (length) (depth to top)

sand 163 167

2", PVC
 (size) (material)

sandy clay 167 176

(6) pump (HP) (yield gpm)

sand 176 189

(type power)

sandy clay 189 205

(7) electric log (yes or no)

" " 205 228

(organization running log)


hard blue clay 222 228

(8) how well bottom plugged

good sand 228 230

sandy clay 230 258

DRILLERS REMARKS:

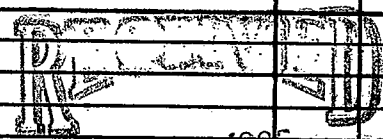

SFP - 6 1985

Department of Natural Resources
 Bureau of Land & Water Resources

If well telescopes please sketch and show depths.

GROUND LEVEL

70' 4"

163' 5"

20' depth screen

SECTION _____

Please indicate well location X.

ADDITIONAL INFORMATION

If more than one screen, show locations of each on sketch.