

MISSISSIPPI DEPARTMENT OF NATURAL RESOURCES

Bureau of Land and Water Resources

Southport Mall

P.O. Box 10631

Jackson, Mississippi 39209

WATER WELL DRILLERS LOG

LOWNDES
L 2014

11-26-85 19
date well completed

Clardy Well Drilling Lowndes
firm name

county well located

LANDOWNER: Edward Bonner

description of formations encountered

from

to

1220 Wilson Dr.

Brown Clay

0

10

Colo, MS. 39702

sand & gravel

10

31

(mailing address)

sandy blue clay

31

36

WELL LOCATION:

blue clay

36

46

sec. 1 T. 19 N. R. 18 E.

sandy blue clay

46

57

3 1/2 miles So. of Colo

blue clay

57

70

(distance) (direction) (nearest town)

rock

70

72

WELL PURPOSE: home
(home, irrigation, municipal, industrial)

sandy clay

72

75

WELL COMPLETION DATA:

streak of sand

75

86

(1) diameter (inches) 4"

sand

86

87

(2) total depth (feet) 148'

blue clay

87

(3) static water level (feet) 25' below above-top of ground.

sand

102

105

(4) casing PVC 72'
(material) (depth)

good sand

105

116

4"
(size) if telescope see back.

sand

116

117

(5) screen (length) (depth to top)

good sand

117

131

(size) (material)

white clay

131

137

(6) pump 1/2 900 gph.
(HP) (yield gpm)

good sand

137

148

elec.
(type power)

(7) electric log no
(yes or no)

RECEIVED

DEC 30 1985

(organization running log)

Department of Natural Resources
Bureau of Land & Water Resources


(8) how well bottom plugged

DRILLERS REMARKS:

6 mi. on Hughes Rd. left on Wilson Dr.

If well telescopes please sketch and show depths.

GROUND LEVEL

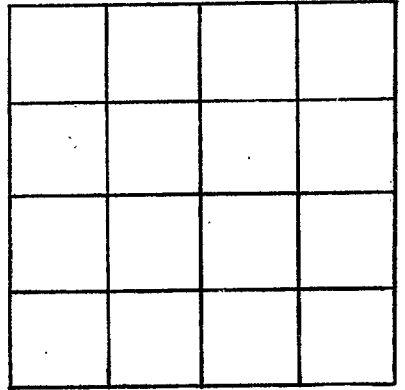

SECTION _____

Please indicate well location X.

ADDITIONAL INFORMATION

If more than one screen,
show locations of each on sketch.