

**MISSISSIPPI DEPARTMENT OF NATURAL RESOURCES**  
**Bureau of Land and Water Resources**  
 Southport Mall  
 P.O. Box 10631  
 Jackson, Mississippi 39209  
**WATER WELL DRILLERS LOG**

Lowndes  
L 2015

2-3-86 19 Mid South Drilling Co. Lowndes  
 date well completed firm name county well located

**LANDOWNER:** John Lindsey  
137 Christopher Drive  
Columbus, Miss 39701  
 (mailing address)

**WELL LOCATION:**  
 sec 27 T 18 R 18  
2 miles south of Columbus  
 (distance) (direction) (nearest town)

**WELL PURPOSE:** home  
 (home, irrigation, municipal, industrial)

**WELL COMPLETION DATA:**

- (1) diameter (inches) 4"
- (2) total depth (feet) 195'
- (3) static water level (feet) \_\_\_\_\_ below above top of ground.
- (4) casing \_\_\_\_\_ (material) \_\_\_\_\_ (depth) \_\_\_\_\_ (size) if telescope see back.
- (5) screen 10' \_\_\_\_\_ 185' \_\_\_\_\_ (length) (depth to top)
- 4" \_\_\_\_\_ 0.32 \_\_\_\_\_ pvc \_\_\_\_\_ (size) (material)
- (6) pump 1/2 \_\_\_\_\_ 10 \_\_\_\_\_ (HP) (yield gpm)  
 \_\_\_\_\_ (type power)
- (7) electric log \_\_\_\_\_ (yes or no)  
 \_\_\_\_\_ (organization running log)
- (8) how well bottom plugged \_\_\_\_\_


description of formations encountered	depth	
	from	to
clay	0	7
sand + gravel	7	35
clay	35	90
clay + sand	90	135
clay	135	145
sand	145	155
clay	155	161
sand	161	174
clay	174	178
sand	178	180
clay	180	195

**RECEIVED**  
 MAR 24 1986  
 Department of Natural Resources  
 Bureau of Land & Water Resources

**DRILLERS REMARKS:** \_\_\_\_\_

If well telescopes please  
sketch and show depths.

GROUND LEVEL

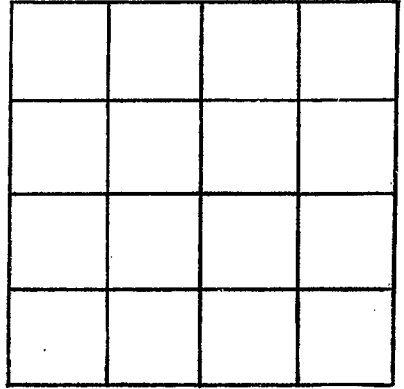

SECTION \_\_\_\_\_

Please indicate well location X.

ADDITIONAL INFORMATION

If more than one screen,  
show locations of each on sketch.