

MISSISSIPPI DEPARTMENT OF NATURAL RESOURCES

Bureau of Land and Water Resources

Southport Mall

P.O. Box 10631

Jackson, Mississippi 39209

WATER WELL DRILLERS LOG

LOWNDES  
L 2016

5-2-86  
date well completed

Clardy Well Drilling Lowndes  
firm name county well located

LANDOWNER: C E Chisom

Hughes Rd.

Colo, MS.

(mailing address)

WELL LOCATION:

sec. 13 T. 19 N R. 18 E  
5 miles S. of Colo.  
(distance) (direction) (nearest town)

WELL PURPOSE: Home  
(home, irrigation, municipal, industrial)

WELL COMPLETION DATA:

- (1) diameter (inches) 4"
- (2) total depth (feet) 176'
- (3) static water level (feet) 30' below top of ground.
- (4) casing PVC 45'  
(material) (depth)  
if telescope see back.  
(size)
- (5) screen  
(length) (depth to top)  
(size) (material)
- (6) pump 1/2 900 gph  
(HP) (yield gpm)  
elec.  
(type power)
- (7) electric log no  
(yes or no)  
(organization running log)
- (8) how well bottom plugged

description of formations encountered	from	to
Red sandy clay	0	12
gravel	12	33
sandy clay	33	42
brown sandy clay	42	58
good clay	58	62 1/2
sandy clay	62 1/2	70 1/2
good clay	70 1/2	73 1/2
brn. rock		
Clay	73 1/2	76
sm. rock	76	77 1/2
sandy clay	77 1/2	79 1/2
clay	79 1/2	97
sandy streaks	97	102
Clay	102	116
sandy clay	116	119
Clay	119	136
sandy clay	136	139
streaks of sand	139	145
sandy like clay	145	148
rock	148	
Clay	148	152
rocky sand streaks	152	174
white clay	174	176

RECEIVED


JUN 24 1986

Department of Natural Resources  
Bureau of Land & Water Resources

DRILLERS REMARKS:

If well telescopes please sketch and show depths.

GROUND LEVEL

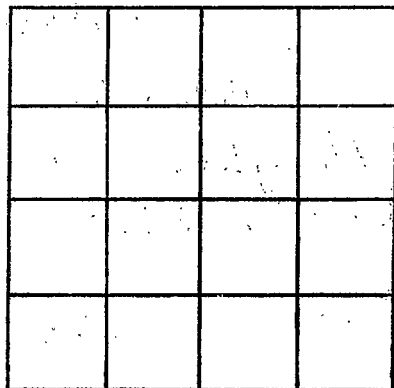

SECTION \_\_\_\_\_

Please indicate well location X.

ADDITIONAL INFORMATION

If more than one screen,  
show locations of each on sketch.