

MISSISSIPPI DEPARTMENT OF NATURAL RESOURCES

Bureau of Land and Water Resources

Southport Mall

P.O. Box 10631

Jackson, Mississippi 39209

WATER WELL DRILLERS LOG

LOWNDES  
L 2017

5-9-86  
date well completed

Clardy Well Drilling Lowndes  
firm name county well located

LANDOWNER: Dale Darnell

P.O. Box 115  
Caldonia, Ms.  
(mailing address)

WELL LOCATION:


sec. 10 T. 19 N R. 18 E  
4 miles S of Caldonia  
(distance) (direction) (nearest town)

WELL PURPOSE: Camp house  
(home, irrigation, municipal, industrial)

WELL COMPLETION DATA:

- (1) diameter (inches) 4"
- (2) total depth (feet) 177'
- (3) static water level (feet) 18 below top of ground.
- (4) casing PVC 54' (material) (depth)  
if telescope see back.
- (5) screen (length) (depth to top)  
(size) (material)
- (6) pump 1/2 900 gpk (HP) (yield gpm)  
(type power)
- (7) electric log no (yes or no)  
(organization running log)
- (8) how well bottom plugged

description of formations encountered	from to	
Brown clay	0	18
gravel	18	19
blue clay	19	31
good clay	31	37
soft clay	37	40
yellow clay	40	55
good blue clay	55	63
sandy clay	63	67
good clay	67	84
rock	84	86
clay	86	97
sand	97	107
clay	107	107
sandy	107	108
blue clay	108	151
rock	151	153
sand	153	177

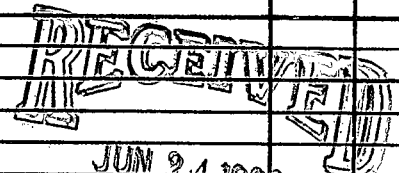


DRILLERS REMARKS:

Department of Natural Resources  
Bureau of Land & Water Resources

If well telescopes please sketch and show depths.

GROUND LEVEL

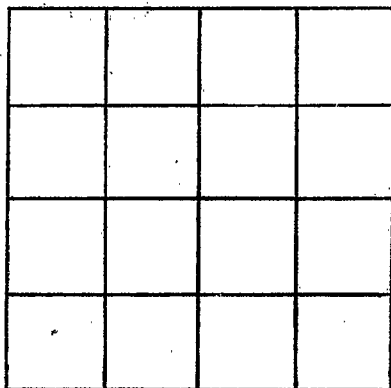

SECTION \_\_\_\_\_

Please indicate well location X.

ADDITIONAL INFORMATION

If more than one screen,  
show locations of each on sketch.