

MISSISSIPPI DEPARTMENT OF NATURAL RESOURCES

Bureau of Land and Water Resources

P.O. Box 10631

Jackson, Mississippi 39209

WATER WELL DRILLERS LOG

COUNTY WELL LOCATED Howards	
WELL NUMBER L 2023	CODED
DATE WELL COMPLETED 1/30/88	

PERMIT NUMBER
NAME OF DRILLING FIRM Clardy Well Drill Columbus, Mo.

NAME & MAILING ADDRESS OF LANDOWNER Charles R. Hoad		
Maplewood Ferry Rd.		
Columbus, Mo 39702		
WELL LOCATION: SEC	TOWNSHIP	RANGE
15	19	18
DISTANCE 5 1/4 Miles	DIRECTION South of	NEAREST TOWN Columbus
OTHER LANDMARK		
WELL PURPOSE: Home, Irrigation, Municipal, Industrial, Fish Pond, etc. Home		

PUMP DATA		
PUMP TYPE (Circle One): Submersible , Turbine, Jet, Flowing Well, Other (Describe) _____		
POWER TYPE (Circle One): Electric , Tractor, Diesel, Gasoline, Butane, Other (Describe) _____		
Pump Capacity (GPM) 900	No. of Stages 10	Setting Depth 60 FT.
PUMP TEST		
Well yielded 900 GPM with a drawdown of _____ ft. after _____ hours of pumping		

WELL DATA		
Well Depth 182	Casing Diameter (In.) 4"	Casing Length (Ft.) 98' 4"
Type of Casing PVC	Hole Depth	Depth to Static Water Level 9'
TYPE OF COMPLETION: (Circle One or More): Gravel Packed, Underreamed, Telescoped, Natural Development, Open Hole, Other (Describe) _____		
Top of Lap Pipe or Reduction in Casing FEET IF TELESCOPED OR MORE THAN ONE SCREEN: USE BACK PAGE		

LOG DATA	
TYPE OF LOG RUN (Circle One): No Log Run, Electric, Gamma Ray, Density, Sonic, Neutron, Other (Describe) _____	
Name of Organization Running Log	

SCREEN DATA		
Diameter - Inches	Length - Feet	Slot Size - Inches
Screen Type	Depth to Bottom - Feet	


GEOLOGIC DATA (Office Use Only)			
Surface Elev.	Geologic Unit	Unit Thickness	Depth to Top
Subs. SWL	Date	Analysis	Aquifer Test
<div style="font-size: 2em; opacity: 0.5; transform: rotate(-45deg); position: absolute; top: 50%; left: 50%;">REGISTRATION</div>			
Driller's Remarks FEB 26 1988			

DESCRIPTION OF FORMATIONS ENCOUNTERED	FROM	TO	FORMATIONS (Continued)	FROM	TO
Grey sandy clay	0	17	Small rock		81
sand + gravel	17	21	Clay	81	82
Blue clay	21	73	Rocky streak	82	84
Small rock		73	sandy clay	84	85 1/2
Clay	73	75	Small rock		85 1/2
Small rock		75	sandy clay	85 1/2	90
Clay	75	78 1/2	Clay	90	92 1/2
sm. rock		78 1/2	Small rock		92 1/2
Clay	78 1/2	80	Clay	92 1/2	96
Small rock		80	sandy clay	96	96 1/2
Clay	80	81			

IF MORE SPACE IS NEEDED, USE BACK

If well telescopes please sketch and show depths.

GROUND LEVEL

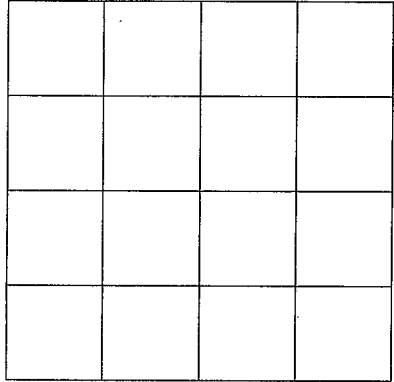

SECTION _____

Please indicate well location X.

ADDITIONAL INFORMATION

Clay	96 $\frac{1}{2}$ - 98
Sandy clay	98 - 104
Clay	104 - 111 $\frac{1}{2}$
Small rock	111 $\frac{1}{2}$
Clay	111 $\frac{1}{2}$ - 145
Sandy clay	145 - 150
Small rock	150
Sandy Clay	150 - 152

If more than one screen, show location of each on sketch.