

LOWNDES
M
8-4-76

MISSISSIPPI
 BOARD OF WATER COMMISSIONERS
 416 North State Street
 134 Jackson, Mississippi 39201

WATER WELL DRILLERS LOG

8-4 1976 WJ REEVER & SON LOWNDES
 date well completed firm name county well located

LANDOWNER: PETE O'BRYANT
RT 4
COLUMBUS
 (mailing address)
 WELL LOCATION:
 sec. 9 T 19 N R 19 E
 S W
7 miles SE of COLUMBUS
 (distance) (direction) (nearest town)

description of formations encountered	from	to
	<u>CLAY</u>	<u>0</u>
<u>BLUE CLAY</u>	<u>22</u>	<u>138</u>
<u>SAND</u>	<u>138</u>	<u>155</u>
<u>CLAY</u>	<u>155</u>	<u>170</u>
<u>SAND</u>	<u>170</u>	<u>200</u>

WELL PURPOSE: HOME
 (home, irrigation, municipal, industrial)

- WELL COMPLETION DATA:
- (1) diameter (inches) 4
 - (2) total depth (feet) 200
 - (3) static water level (feet) 75 below above top of ground.
 - (4) casing PVC 121
 (material) (depth)
4 if telescope see back.
 (size)
 - (5) screen _____
 (length) (depth to top)
 (size) (material)
 - (6) pump 1/2 7
 (HP) (yield gpm)
ELECT.
 (type power)
 - (7) electric log NO
 (yes or no)
 (organization running log)
 - (8) how well bottom-plugged OPEN


DRILLERS REMARKS:

RECEIVED
 APR 12 1977

MISS. BD. OF WATER COMMISSIONERS

If well telescopes please sketch and show depths.

GROUND LEVEL

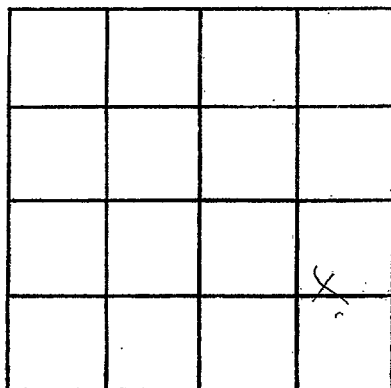

SECTION 9

Please indicate well location X.

ADDITIONAL INFORMATION

Lined area for providing additional information, consisting of approximately 20 horizontal lines.

If more than one screen, show locations of each on sketch.