

CODED

MISSISSIPPI
BOARD OF WATER COMMISSIONERS
416 North State Street
Jackson, Mississippi 39201

CODED

WATER WELL DRILLERS LOG

Lowndes
M 10
8-68

Aug. 1968 date well completed
68 Clardy Well Drilling firm name
Lowndes county well located

LANDOWNER: Grady Nash
Golden Rd.
Columbus, Miss.
(mailing address)

description of formations encountered	from	to
Top soil	0	25
Blue Clay	25	190
Sand	190	210
Blue Clay	210	215
Sand	215	230
White Clay	220	236

WELL LOCATION:
sec. 9 T. 19 N. R. 17 E. 7
SW W

WELL PURPOSE: Home
(home, irrigation, municipal, industrial)

- WELL COMPLETION DATA:
- (1) diameter (inches) 4"
 - (2) total depth (feet) 236'
 - (3) static water level (feet) 16 below top of ground.
 - (4) casing 48' 7"
(material) (depth)
 - (size) if telescope see back.
 - (5) screen (length) (depth to top)
 - (size) (material)
 - (6) pump 1/2 hp Subm. 500gph
(HP) (yield gpm)
 - (type power)
 - (7) electric log No
(yes or no)
 - (organization running log)
 - (8) how well bottom plugged

CODED


DEC 13 1968

MISS. BD. OF
WATER COMM.

DRILLERS REMARKS:

If well telescopes please sketch and show depths.

GROUND LEVEL

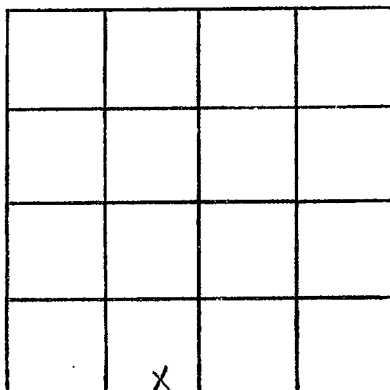

SECTION _____

Please indicate well location X.

ADDITIONAL INFORMATION

If more than one screen,
show locations of each on sketch.