

15  
-4.35  
3.75

**CODED**

MISSISSIPPI  
BOARD OF WATER COMMISSIONERS  
416 North State Street  
Jackson, Mississippi 39201

**CODED**

**WATER WELL DRILLERS LOG**

Lowndes
M 11
11-68

Nov. 23, 1968 Clardy Well Drilling Lowndes  
 date well completed firm name county well located

LANDOWNER: Chesley  
Richard

Description of formations encountered	from	to
Sand-gravel-top sub	0	56
Blue clay	56	75
Strips of clay	75	85
clay	85	115
Fin sand	115	120
Blue clay	120	280
Coarse sand	280	294

Nashville Ferry Rd  
Columbus, Miss.  
 (mailing address)

WELL LOCATION: 17  
 sec. 32 T. 19 N. R. 10 E. W  
 SW NE

\_\_\_\_\_ miles \_\_\_\_\_ of \_\_\_\_\_  
 (distance) (direction) (nearest town)

WELL PURPOSE:  
 (home, irrigation, municipal, industrial)

WELL COMPLETION DATA:

- (1) diameter (inches) 4"
- (2) total depth (feet) 294
- (3) static water level (feet) 110.25 below top of ground.
- (4) casing Steel, 574"  
 (material) (depth)
- \_\_\_\_\_ if telescope see back.  
 (size)
- (5) screen \_\_\_\_\_ / \_\_\_\_\_  
 (length) (depth to top)
- \_\_\_\_\_ / \_\_\_\_\_  
 (size) (material)
- (6) pump \_\_\_\_\_ / \_\_\_\_\_  
 (HP) (yield gpm)
- \_\_\_\_\_ (type power)
- (7) electric log \_\_\_\_\_  
 (yes or no)
- \_\_\_\_\_ (organization running log)
- (8) how well bottom plugged \_\_\_\_\_

**CODED**


DEC 13 1968

MISS. BD. OF  
WATER COMM.

DRILLERS REMARKS:

If well telescopes please sketch and show depths.

GROUND LEVEL

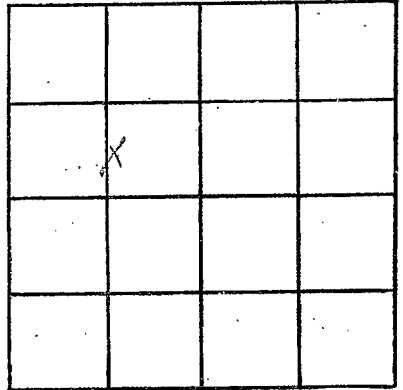

SECTION \_\_\_\_\_

Please indicate well location X.

ADDITIONAL INFORMATION

If more than one screen, show locations of each on sketch.