

MISSISSIPPI
BOARD OF WATER COMMISSIONERS
416 North State Street
Jackson, Mississippi 39201

CODED

CODED

WATER WELL DRILLERS LOG

Lowndes
M 12
42-68

12-2 1968 Clardy Well Drilling Lowndes
date well completed firm name county well located

LANDOWNER: E.H. Forrester

Nashville Ferry Rd.
Columbus, Miss.
(mailing address)

WELL LOCATION: 17
sec. 32 T. 19 N. R. 10 E
SW

(distance) miles (direction) of (nearest town)

WELL PURPOSE: Home
(home, irrigation, municipal, industrial)

WELL COMPLETION DATA:

- (1) diameter (inches) 4"
- (2) total depth (feet) 170
- (3) static water level (feet) 3 below top of ground.

(4) casing Steel 64' 3"
(material) (depth)

(size) if telescope see back.

(5) screen (length) (depth to top)

(size) (material)

(6) pump (HP) (yield gpm)
(type power)

(7) electric log (yes or no)

(organization running log)

(8) how well bottom plugged

description of formations encountered	from	to
Top soil	0	10
Sand & gravel	10	60
Blue Clay	60	80
Streaks of sand	80	85
Blue Clay	85	90
Streaks of sand	90	100
Blue Clay	100	102
Sand	102	105
Rock		
Sand	105	108
Clay	108	140
Sand & shale rock	140	147
Clay	147	155
Streaks of sand	155	160
Clay	160	170

CODED


DEC 13 1968

MISS. BD. OF
WATER COMM.

DRILLERS REMARKS:

If well telescopes please sketch and show depths.

GROUND LEVEL

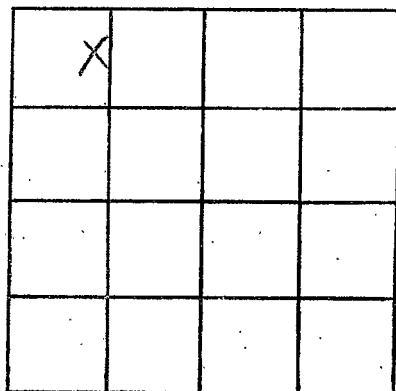

SECTION _____

Please indicate well location X.

ADDITIONAL INFORMATION

If more than one screen, show locations of each on sketch.