

M 15

WATER WELL DRILLERS LOG

CODED

2-26-63

Date: Feb 26, 1963, Driller: W. B. Clardy County Lowndes

14027, 20

(Name)

(1) Owner of Land: F. M. Vaughn (Name)

7 Hwy 69 (Address)

(2) Location: SE 1/4, SE 1/4, Sec. 17 T 19 S R 17 W

1.0 miles So. of Calw (distance) (direction) (Nearest Town)

(3) Topography: Hilly (Hilly) (Flat) (Level)

(4) Purpose of Well: Domestic (Domestic Irrigation Municipal, Industrial, Other)

Description & Color of Materials Sand, Clay, Red Clay, Shell, etc.	Thick- ness Feet	Depth Feet
Red clay	0-15	
Red sand	15-25	
Sand + Gravel	25-35	
Blue clay	35-120	
rocks at 90, 91, 100, 110, 115, 120, 135, 142, 148, 155		
sand + sandy clay	120-165	
Blue clay	165-180	
Fine sand	180-192	
clay	192-200	
sand fine	200-205	
" Med	205-210	
clay	210-228	
sand (good)	228-233	
clay	233-250	
soft sandy clay	250-275	
clay	275-290	
clay (sandy)	290-313	
Sand with small pea gravel	313-337	

Information upon completion of well:

(1) Diameter 4 inches.

(2) Total Depth 337 feet.

(3) Water Level 117 feet below top of ground.

(4) Cased to 166 Size 4
165-337 2 1/2

(5) Screen: Size perforated Length pipe 24'


(6) Were any formations sealed against pollution?
_____ yes, _____ no.

If YES depth of formation _____

Why _____

Drillers Remarks: _____

CODED

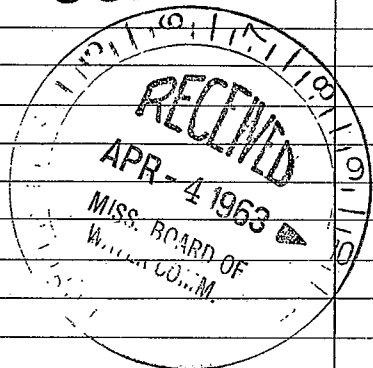

(Use Back Side)

Well No.

