

M16

WATER WELL DRILLERS LOG

2-16-63

Date: Feb. 16, 1963, Driller: W.B. Clardy County Lounes

(Name)

(1) Owner of Land: ^{Changed} Billy Oswalt (Name)

Hwy 69 (Address)

(2) Location: SW SW NE 1/4, 1/4, Sec. 17 T19S R17W

10 miles SW of Calhoun (distance) (direction) (Nearest Town)

(3) Topography: Flat (Hilly) (Flat) (Level)

(4) Purpose of Well: Domestic (Domestic Irrigation Municipal, Industrial, Other)

Description & Color of Materials Sand, Clay, Red Clay, Shell, etc.

Thick-ness Feet

Depth Feet

Brown 6' to 8'
Blue Clay 8' to 65'
Sand 65' to 75'
Blue Clay 75' to 85'
Sand from 85' to 125'

Information upon completion of well:

(1) Diameter 4" inches.

(2) Total Depth 125' feet.

(3) Water Level 8' feet below top of ground.

(4) Cased to 43 1/2', Size 4"


(5) Screen: Size _____, Length _____.

(6) Were any formations sealed against pollution?
_____ yes, _____ no.

If YES depth of formation _____

Why _____

Drillers Remarks: _____

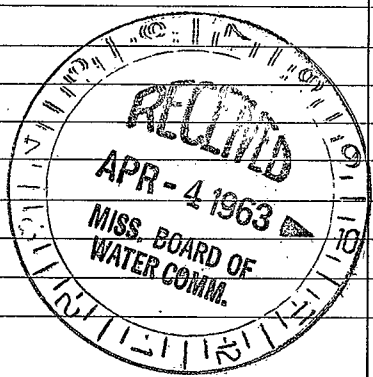

(Use Back Side)

Well No.

1870

1871

1872

1873

1874

1875

1876