

Lowndes
 M17
 3-20-70

MISSISSIPPI
 BOARD OF WATER COMMISSIONERS
 416 North State Street
 Jackson, Mississippi 39201

CODED

WATER WELL DRILLERS LOG

3-20-70 19 Columbus Well Drilling Lowndes
 date well completed firm name county well located

LANDOWNER: Charles B. Stinson
 Route 4
 Columbus, Miss.
 (mailing address)

WELL LOCATION:
 9 sec 34 T 10 R 17E
 10 miles South of Columbus
 (distance) (direction) (nearest town)

WELL PURPOSE: Home
 (home, irrigation, municipal, industrial)

WELL COMPLETION DATA:

- (1) diameter (inches) 4"
- (2) total depth (feet) 200'
- (3) static water level (feet) 53 below above top of ground.
- (4) casing Steel 63' 9" (material) (depth)
 4" (size) if telescope see back.
- (5) screen (length) (depth to top)
 (size) (material)
- (6) pump 1/2 (HP) (yield gpm)
 220 V SP (type power)
- (7) electric log No (yes or no)
 (organization running log)
- (8) how well bottom plugged Open

description of formations encountered	from	to
Gravel	0	10
Clay	10	20
Clay & small gravel	20	40
Blue clay	40	60
Blue clay & gravel	60	80
Clay with heavy gravel	80	100
" " " "	100	120
Clay with some gravel	120	140
Clay with some gravel	140	160
Clay/ gravel (small)	160	200

CODED


MAY 4 1970

MISS. BD. OF WATER COMM.

DRILLERS REMARKS:

If well telescopes please sketch and show depths.

GROUND LEVEL

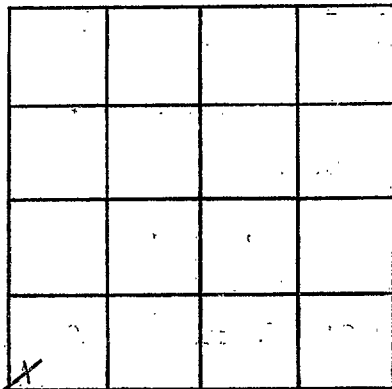

SECTION _____

Please indicate well location X.

ADDITIONAL INFORMATION

If more than one screen, show locations of each on sketch.