

MISSISSIPPI
BOARD OF WATER COMMISSIONERS
416 North State Street
Jackson, Mississippi 39201

CODED

WATER WELL DRILLERS LOG

Lowndes
M 18
5-67

5-25 1967 W. J. REEVES & SON Lowndes
date well completed firm name county well located

LANDOWNER: CHARLES RICHARDSON

description of formations encountered	from	to
RED CLAY	0	4
WHITE CLAY	4	18
BLUE CLAY	18	95
BLUE SAND	95	114
" CLAY	114	122
" SAND	122	130
" CLAY	130	148
" SAND	148	155

RT. 4

COLUMBUS
(mailing address)


WELL LOCATION: 17
sec. 9 T. 19 S. R. 12 E. S. 3
10 miles SE of COLUMBUS
(distance) (direction) (nearest town)

WELL PURPOSE: HOME
(home, irrigation, municipal, industrial)

WELL COMPLETION DATA:

- (1) diameter (inches) 4
- (2) total depth (feet) 155
- (3) static water level (feet) 55 below top of ground.
- (4) casing STEEL, 42" (material), (depth),
4" if telescope see back. (size)
- (5) screen NONE (length), (depth to top)
(size), (material)
- (6) pump 3/4 (HP), 10 (yield gpm)
ELECT (type power)
- (7) electric log NO (yes or no)
(organization running log)
- (8) how well bottom plugged OPEN

CODED

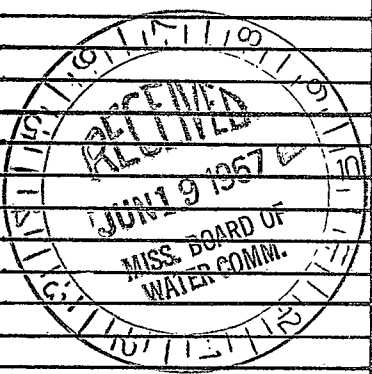

DRILLERS REMARKS:

