

CODED

MISSISSIPPI
BOARD OF WATER COMMISSIONERS
416 North State Street
Jackson, Mississippi 39201

LOWNDES
EM 20
7-30-69

WATER WELL DRILLERS LOG

7-30 19 Columbus Well Drilling Lowndes
date well completed firm name county well located

LANDOWNER: Raiford Deason
Route 4

description of formations encountered	from	to
Gravel & Sand	8	23
Blue clay	23	40
Blue clay	40	70
Sandy streaks & b.clay	70	85
Rock (shale)	85	90
Sand	90	92
Sand streaks	92	109
Coarse Sand	109	111
Sand streaks	111	127
Blue clay	127	129
Sand (Coarse)	129	148

Columbus, Miss.
(mailing address)

WELL LOCATION:
sec. 20 T. 18 R. 17
5 3 3
14 miles NE of COLUMBUS
(distance) (direction) (nearest town)

WELL PURPOSE: None
(home, irrigation, municipal, industrial)

WELL COMPLETION DATA:

- (1) diameter (inches) 4"
- (2) total depth (feet) 150
- (3) static water level (feet) 20 below above top of ground.
- (4) casing Steel, 70'
(material) (depth)
 if telescope see back.
(size)
- (5) screen No
(length) (depth to top)
 (size) (material)
- (6) pump None installed
(HP) (yield gpm)
 (type power)
- (7) electric log No
(yes or no)
 (organization running log)
- (8) how well bottom plugged Open

CODED


SEP - 3 1969

MISS. Bd. of WATER COMMS.

DRILLERS REMARKS:

If well telescopes please sketch and show depths.

GROUND LEVEL

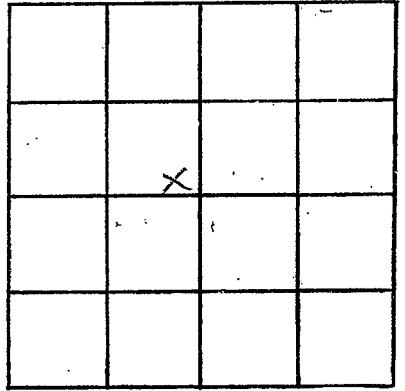

SECTION _____

Please indicate well location X.

ADDITIONAL INFORMATION

If more than one screen, show locations of each on sketch.